
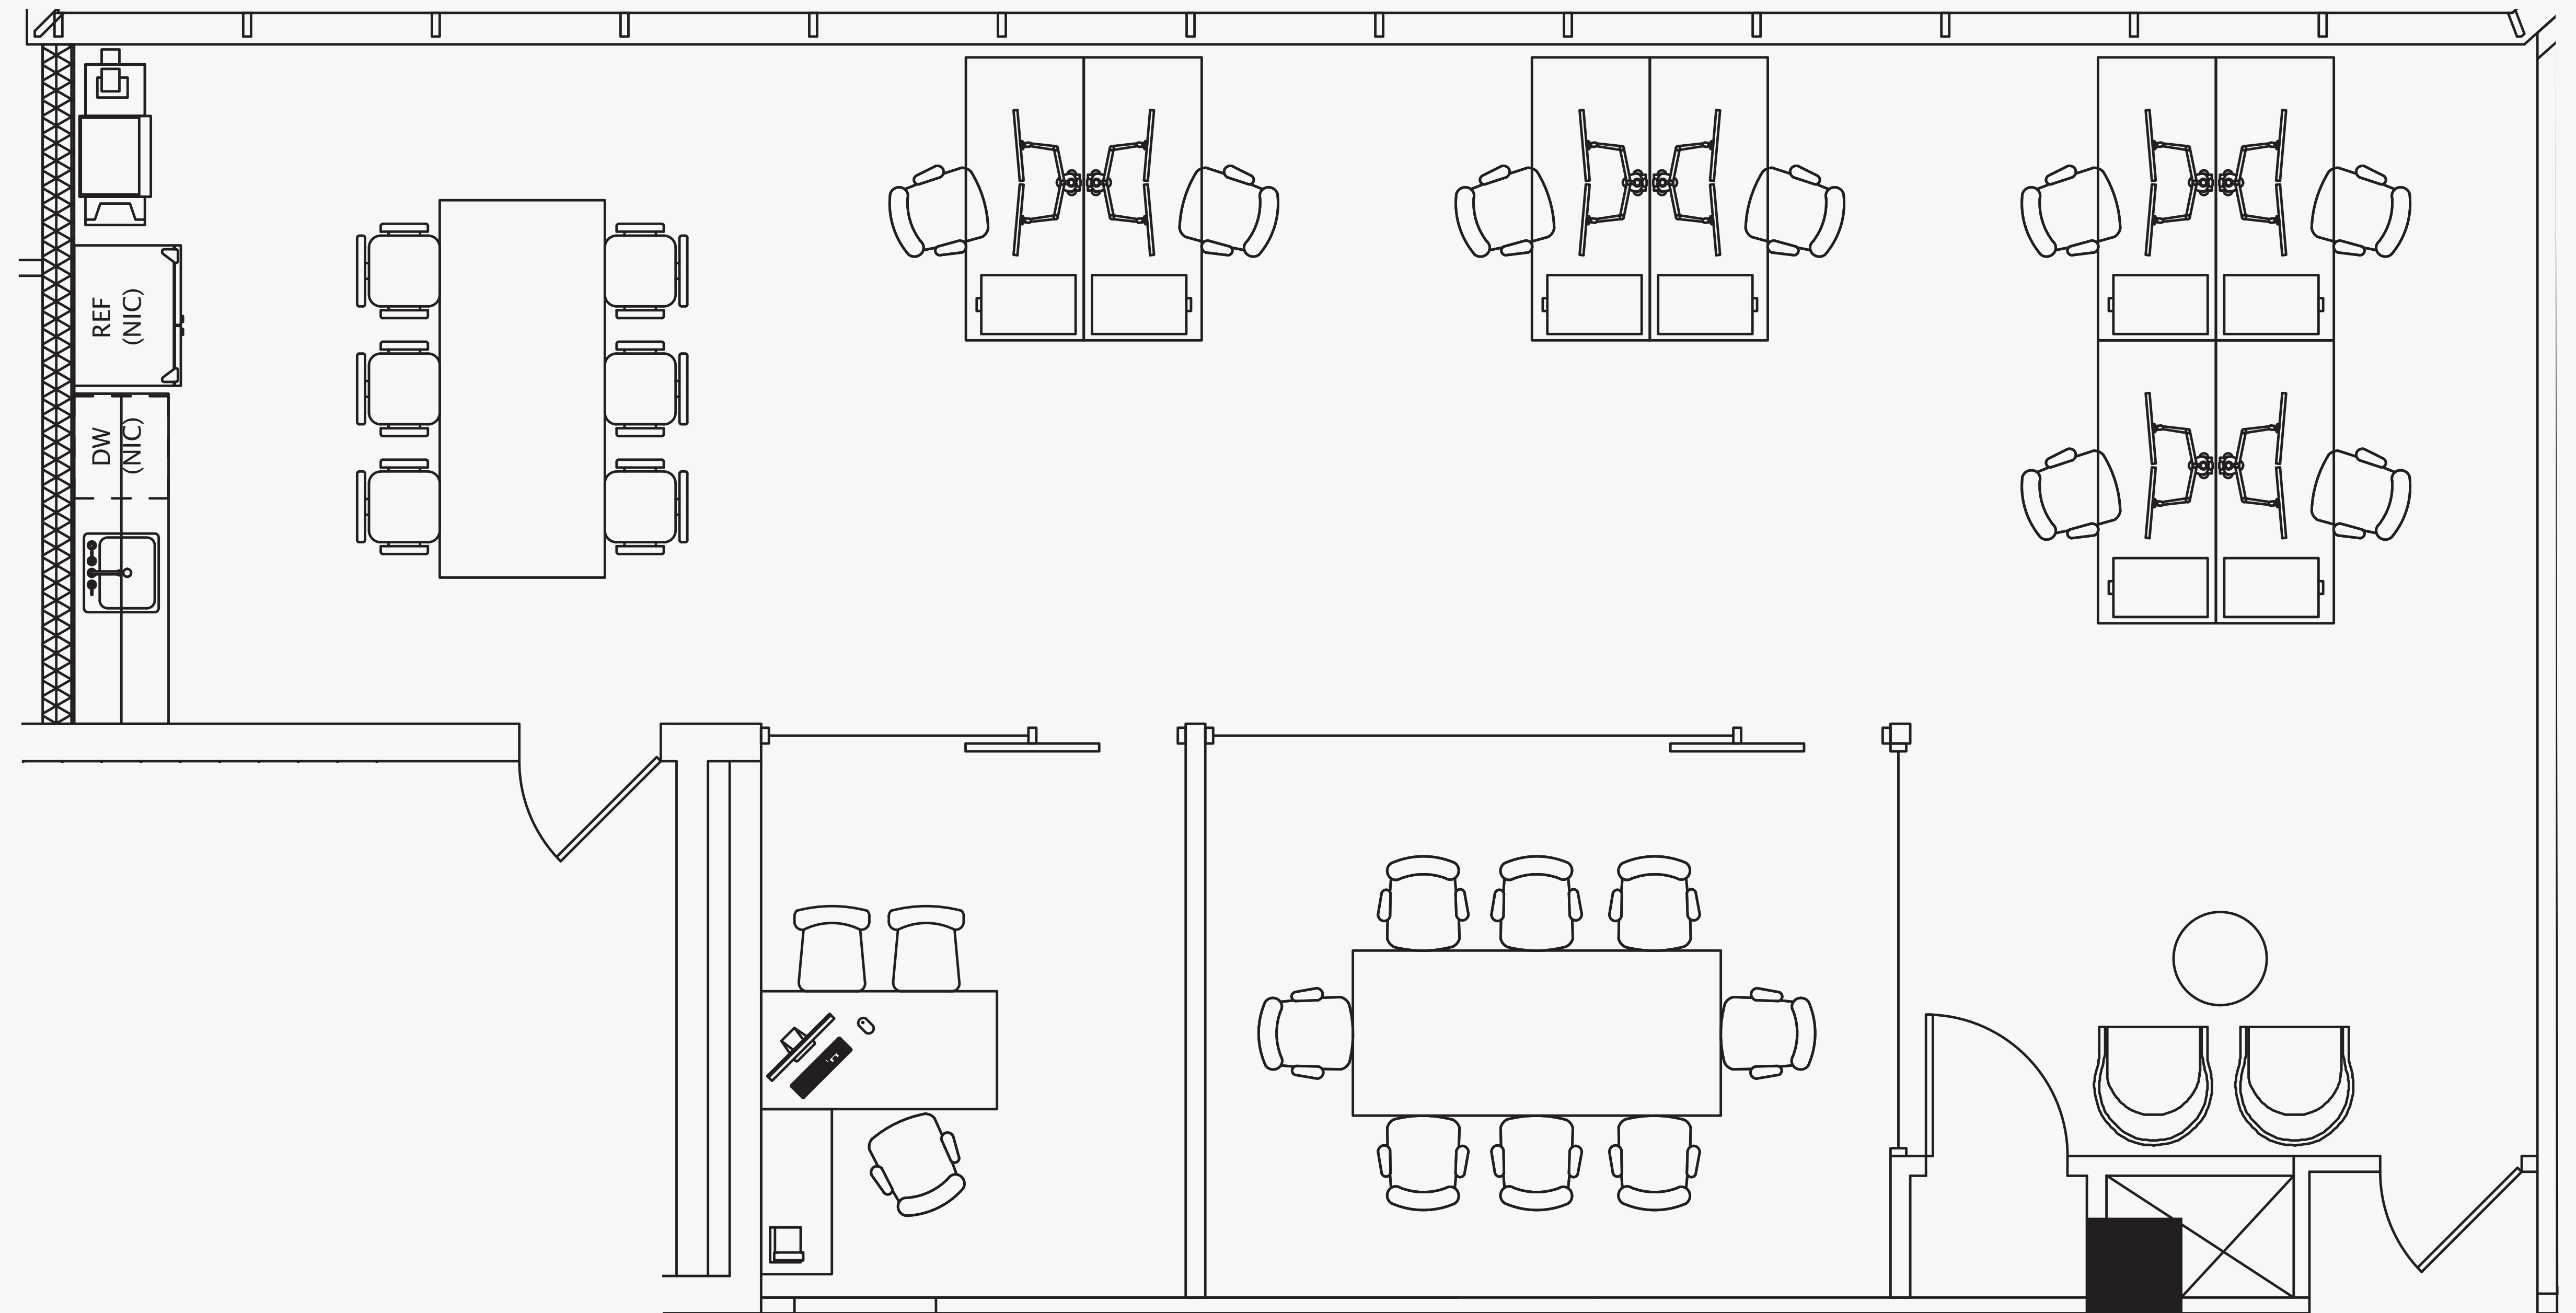


AS-BUILT CONFIGURATION

- OFFICES..... 1
- RECEPTION..... 1
- CONFERENCE ROOMS..... 1
- KITCHEN/BREAKOUT 1
- OPEN WORK AREA..... +/-8

KEY PLAN

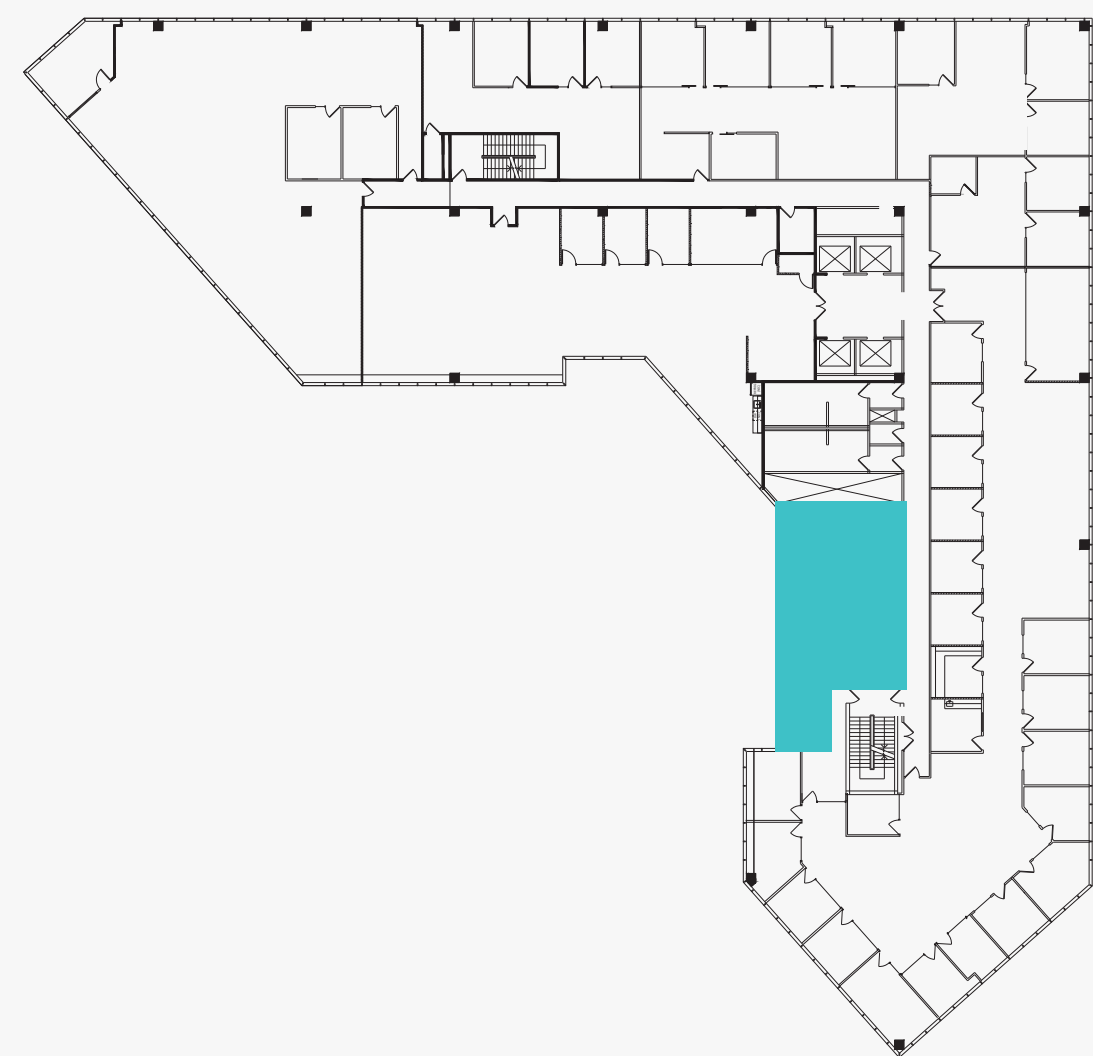

For leasing information please contact:

Tom Sheets	Quint Carroll
310.525.1919	310.525.1931
tom.sheets@cushwake.com	quint.carroll@cushwake.com