


## AS-BUILT CONFIGURATION

OFFICES.....	4
RECEPTION.....	1
CONFERENCE ROOMS.....	1
KITCHEN/BREAKOUT .....	1
OPEN WORK AREA.....	+/- 8

## KEY PLAN

\*FURNITURE AND APPLIANCES NOT INCLUDED\*

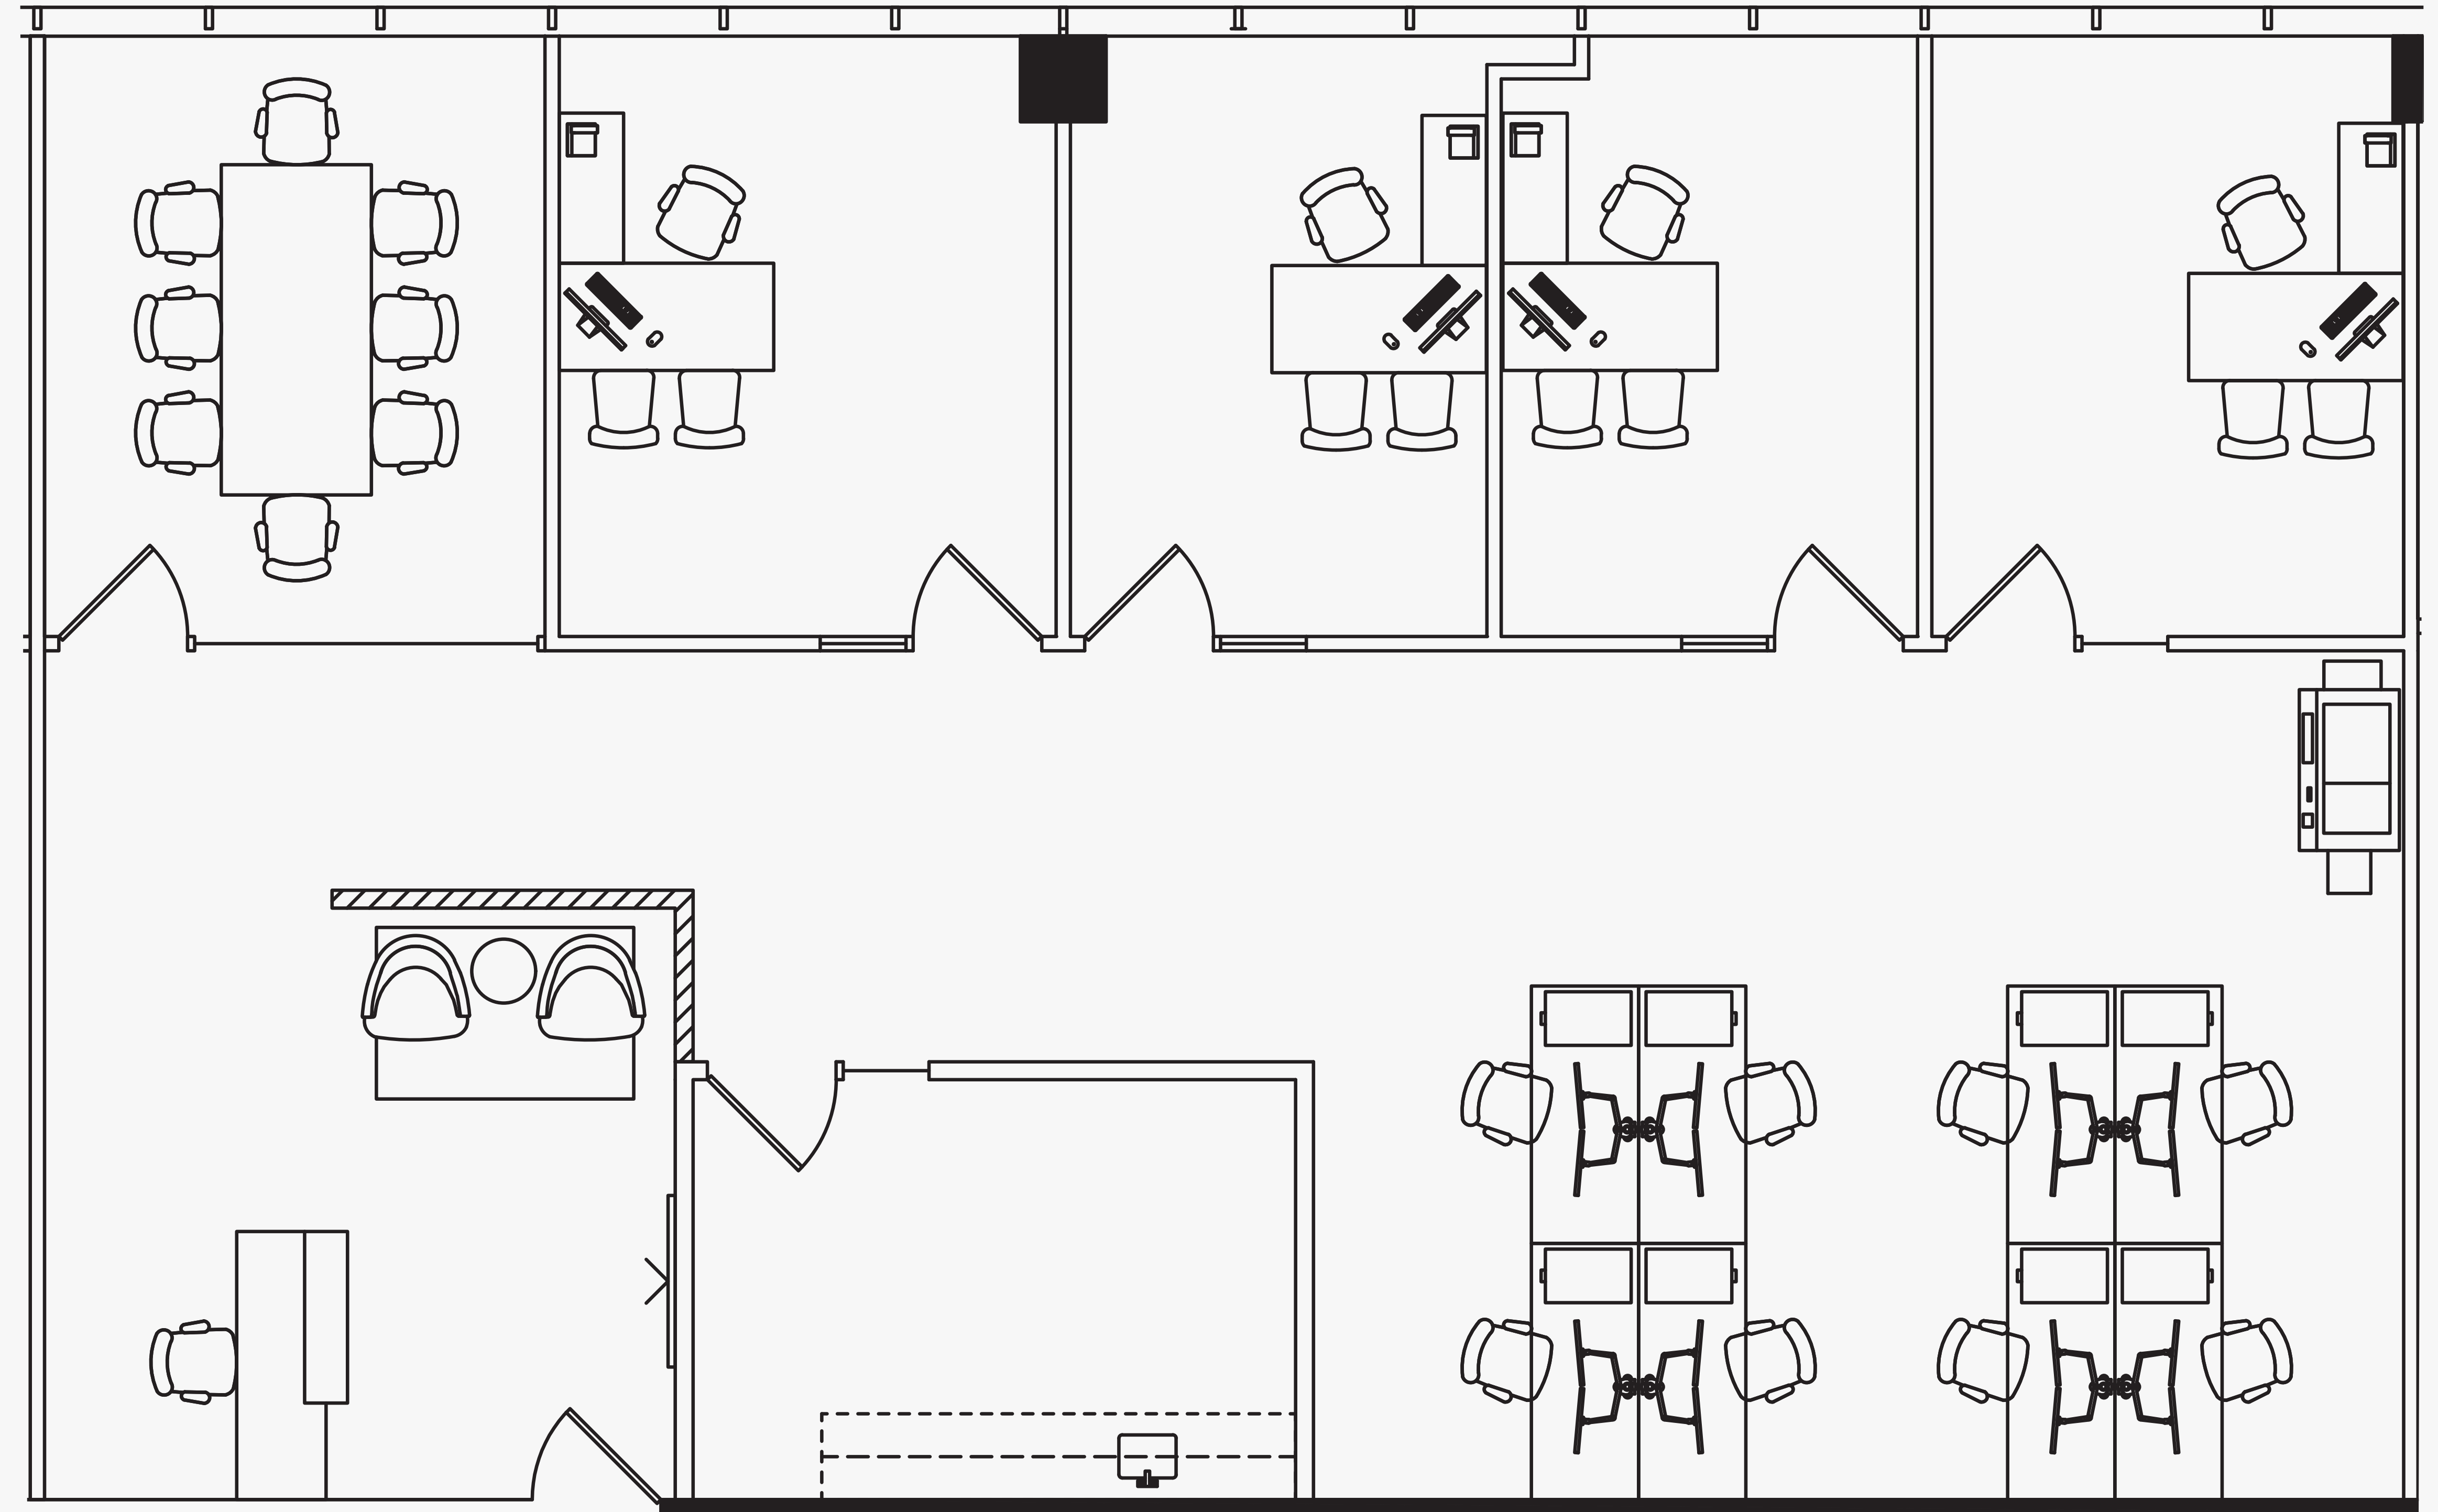

For leasing information please contact:

Tom Sheets	Quint Carroll
310.525.1919	310.525.1931
tom.sheets@cushwake.com	quint.carroll@cushwake.com