
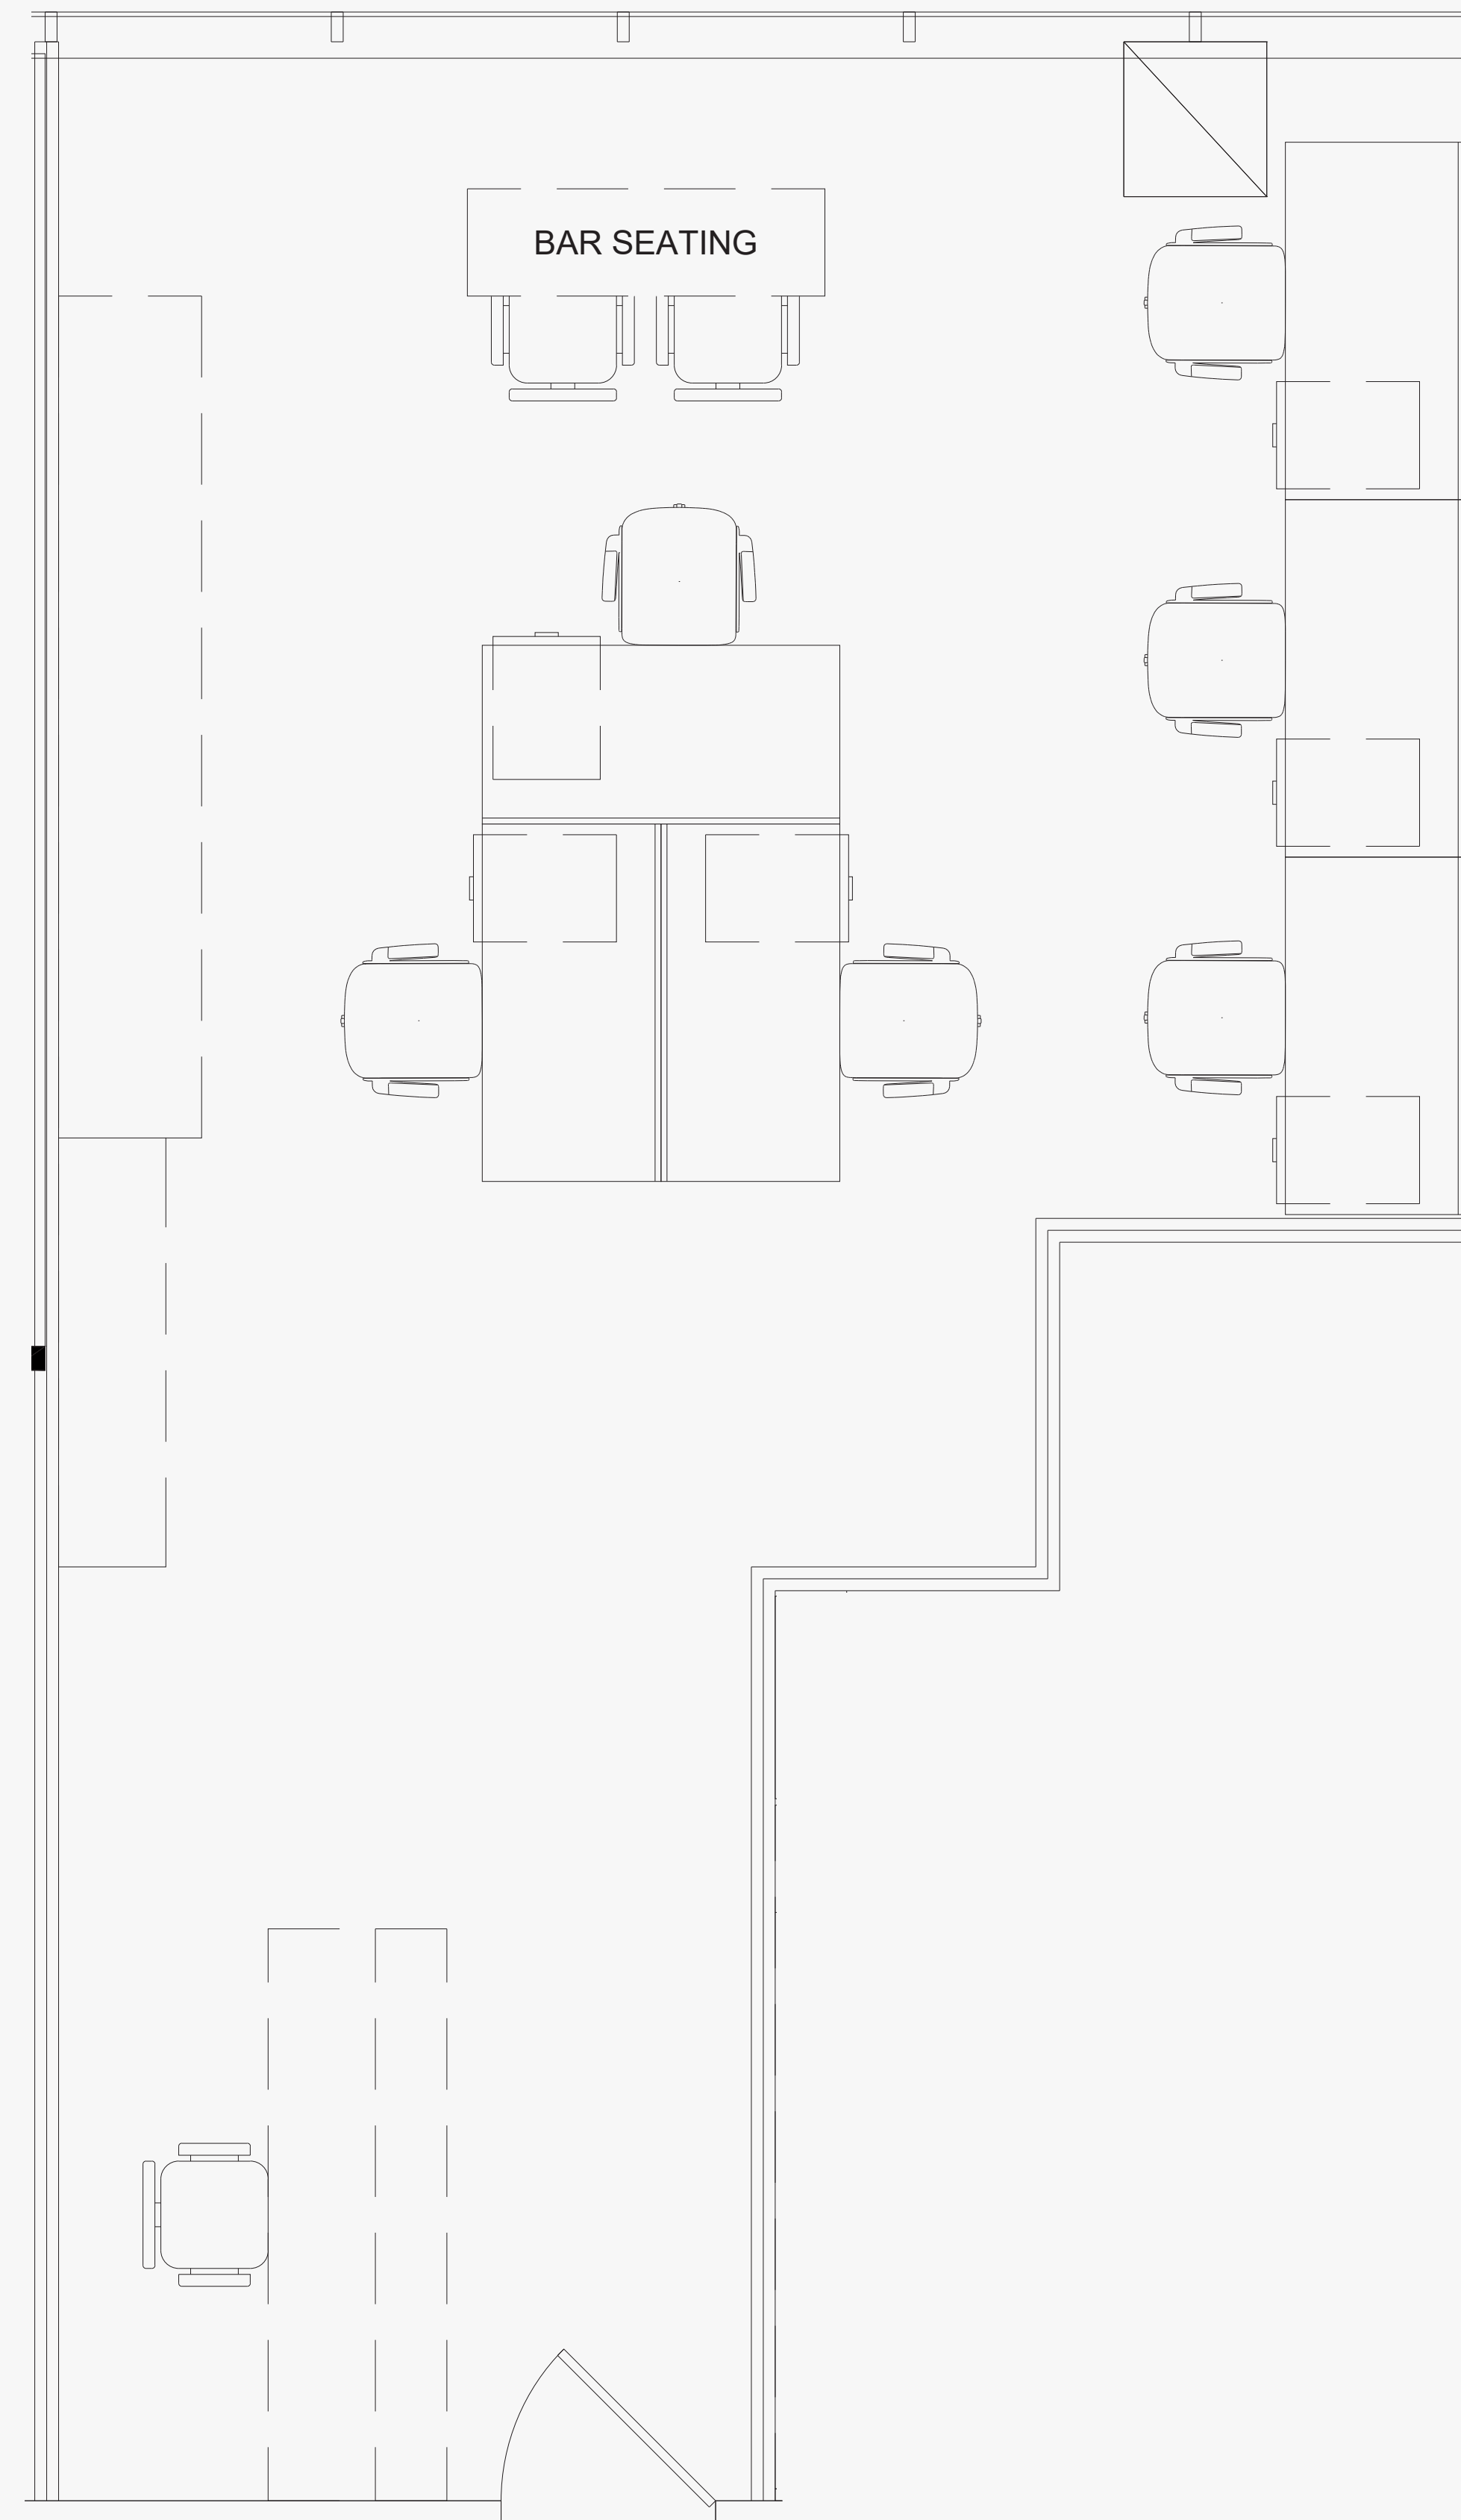


AS-BUILT CONFIGURATION

| | |
|------------------------|-----|
| OFFICES..... | N/A |
| RECEPTION..... | 1 |
| CONFERENCE ROOMS..... | N/A |
| KITCHEN/BREAKOUT | 1 |
| OPEN WORK AREA..... | 6 |

KEY PLAN

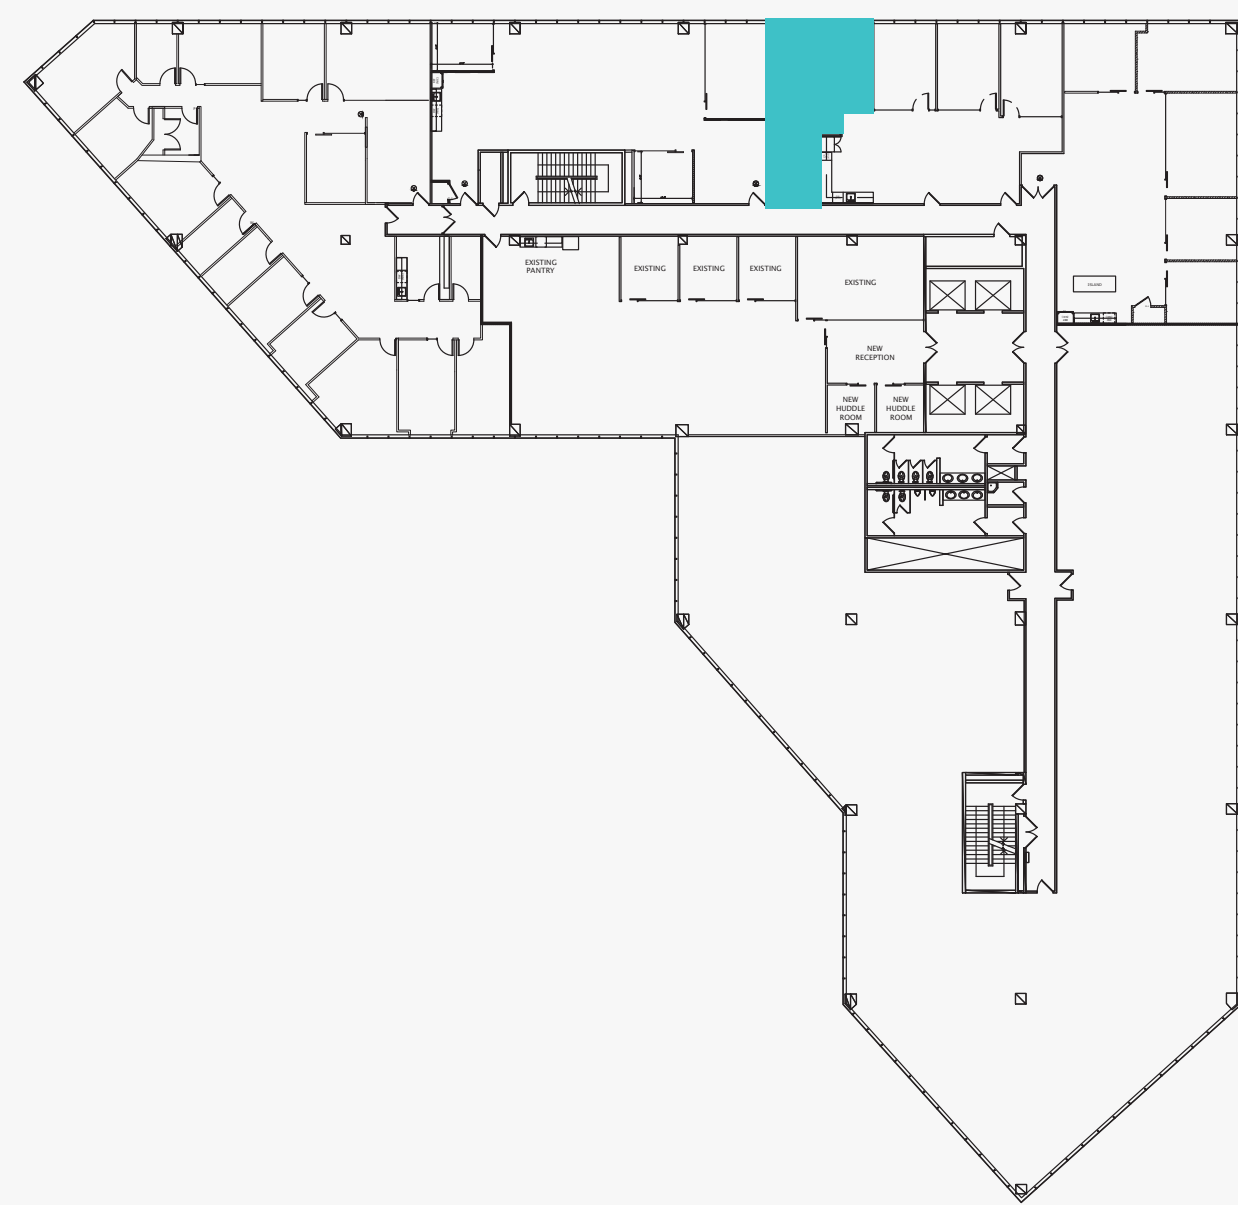

For leasing information please contact:

| | |
|-------------------------|----------------------------|
| Tom Sheets | Quint Carroll |
| 310.525.1919 | 310.525.1931 |
| tom.sheets@cushwake.com | quint.carroll@cushwake.com |