
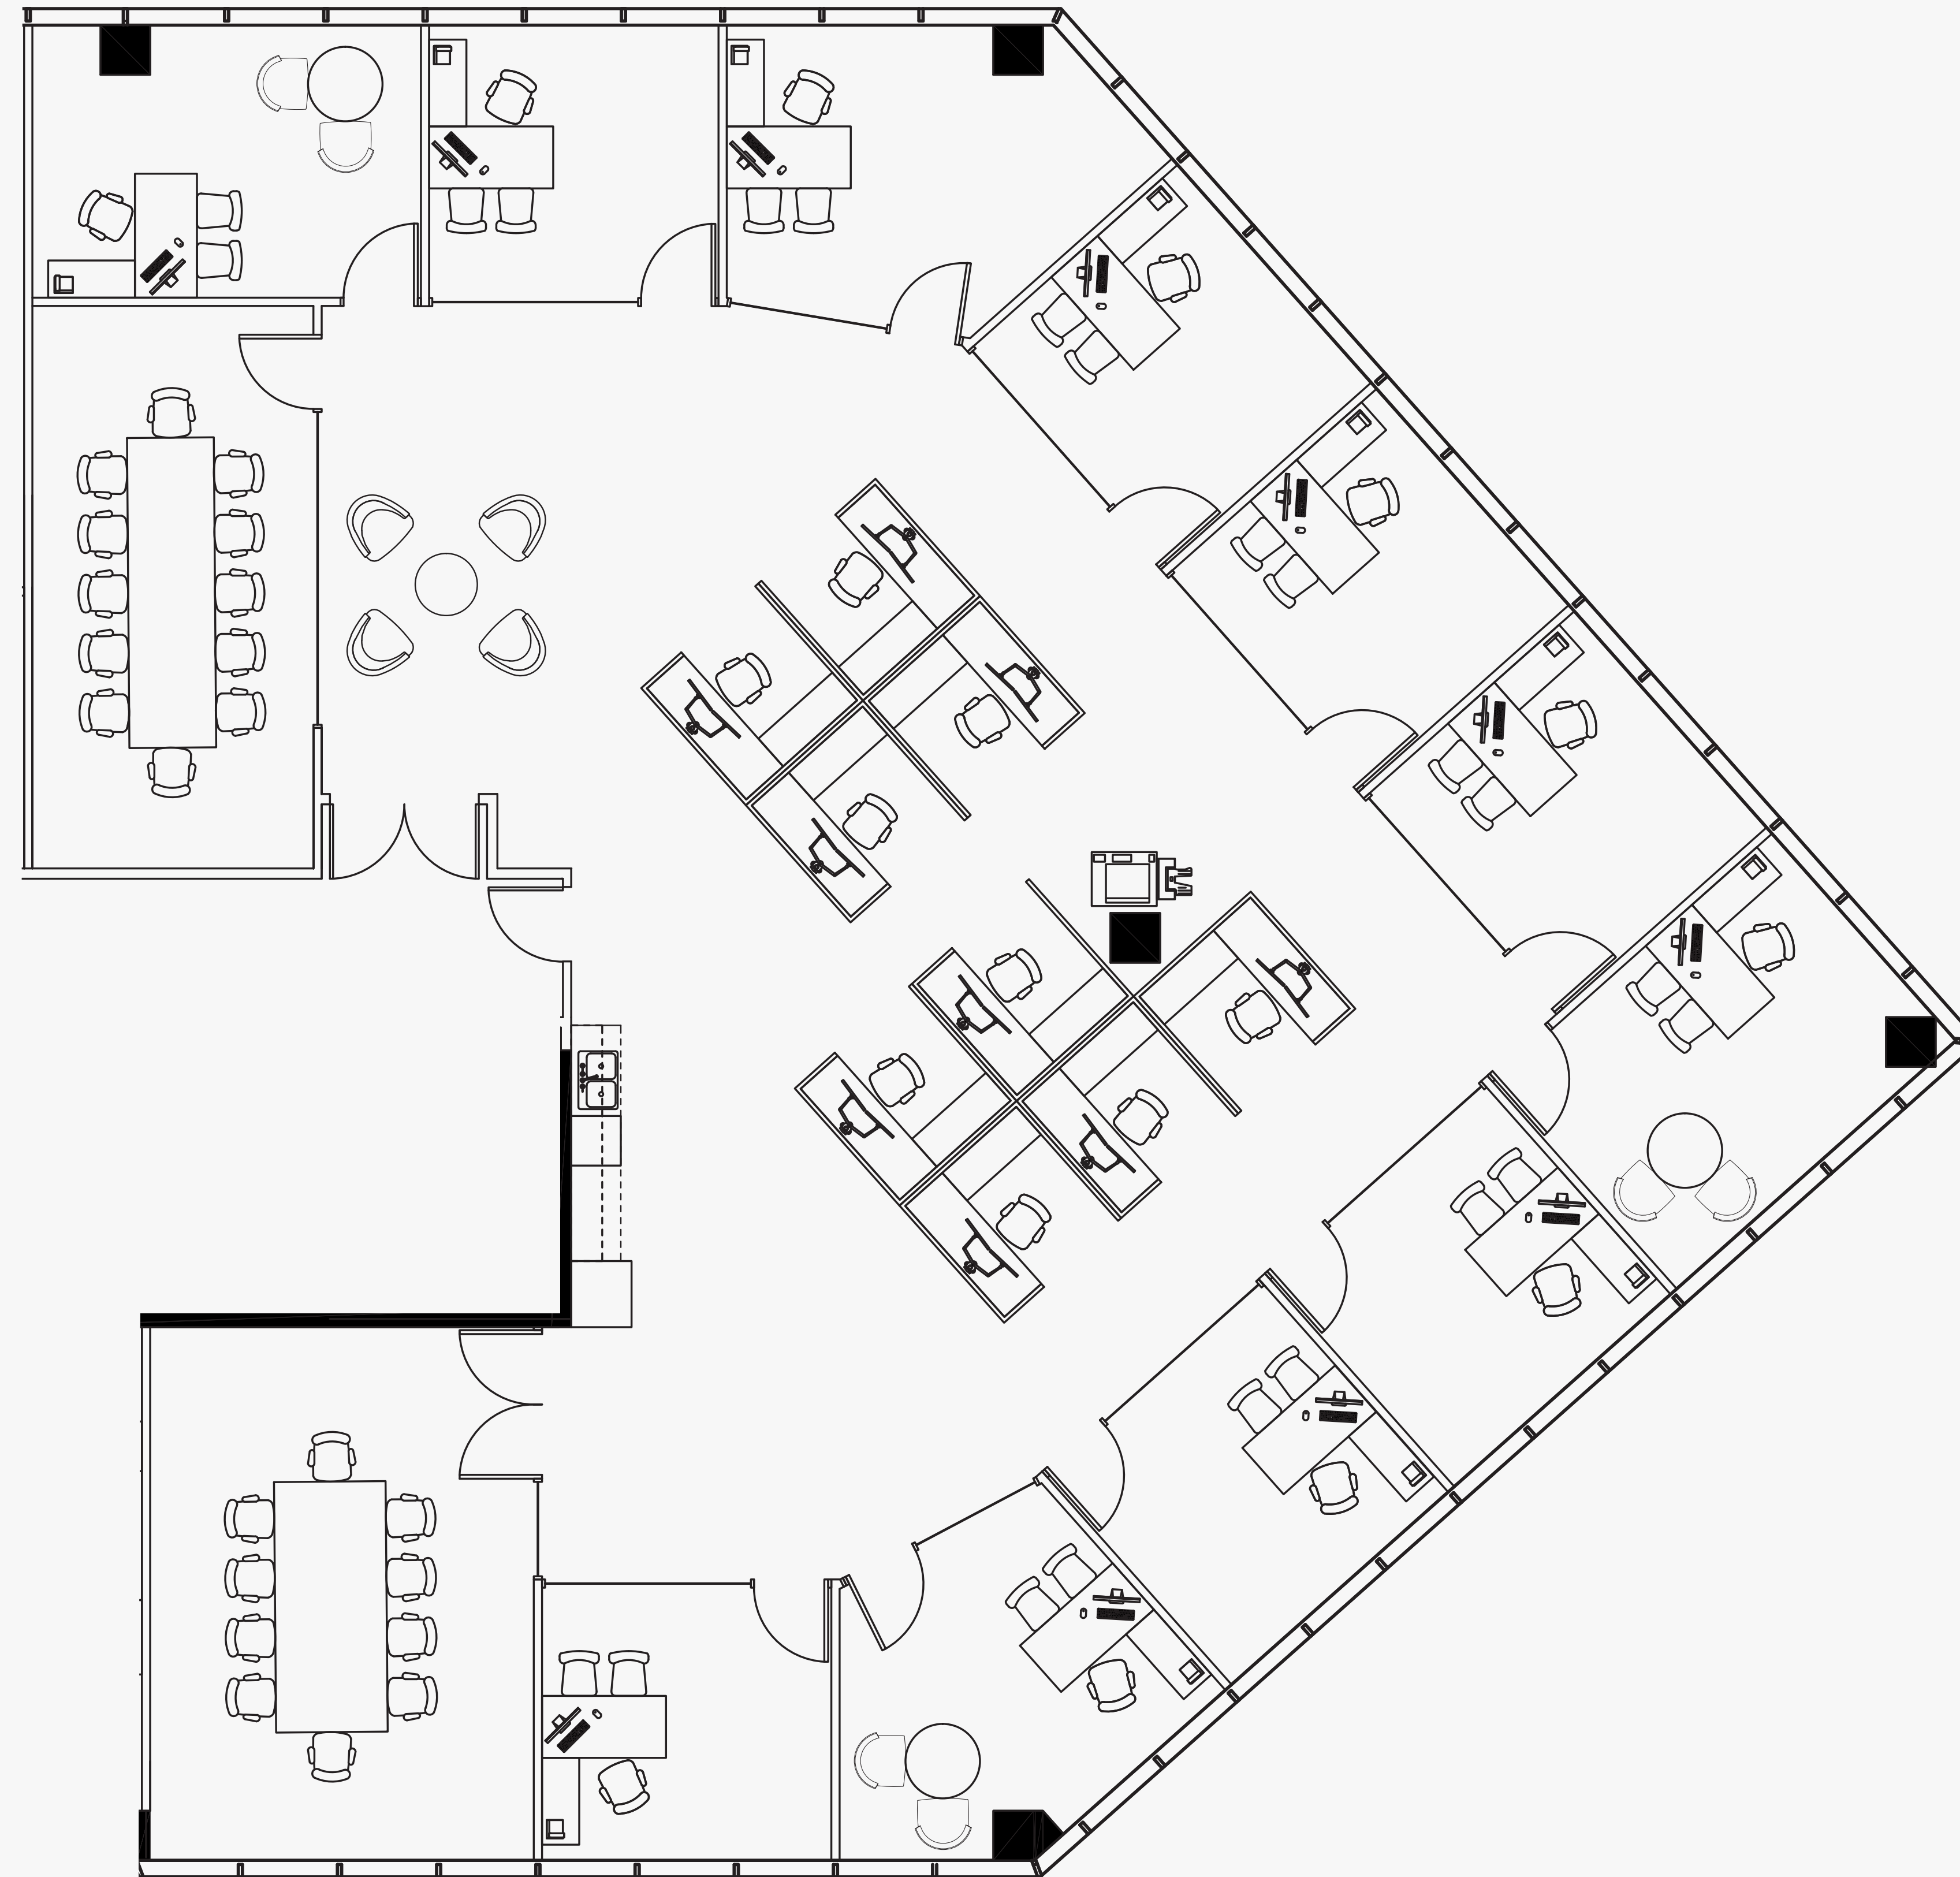


AS-BUILT CONFIGURATION

OFFICES.....	11
RECEPTION.....	1
CONFERENCE ROOMS.....	2
KITCHEN/BREAKOUT	1
OPEN WORK AREA.....	+/- 9

KEY PLAN

FURNITURE AND APPLIANCES NOT INCLUDED

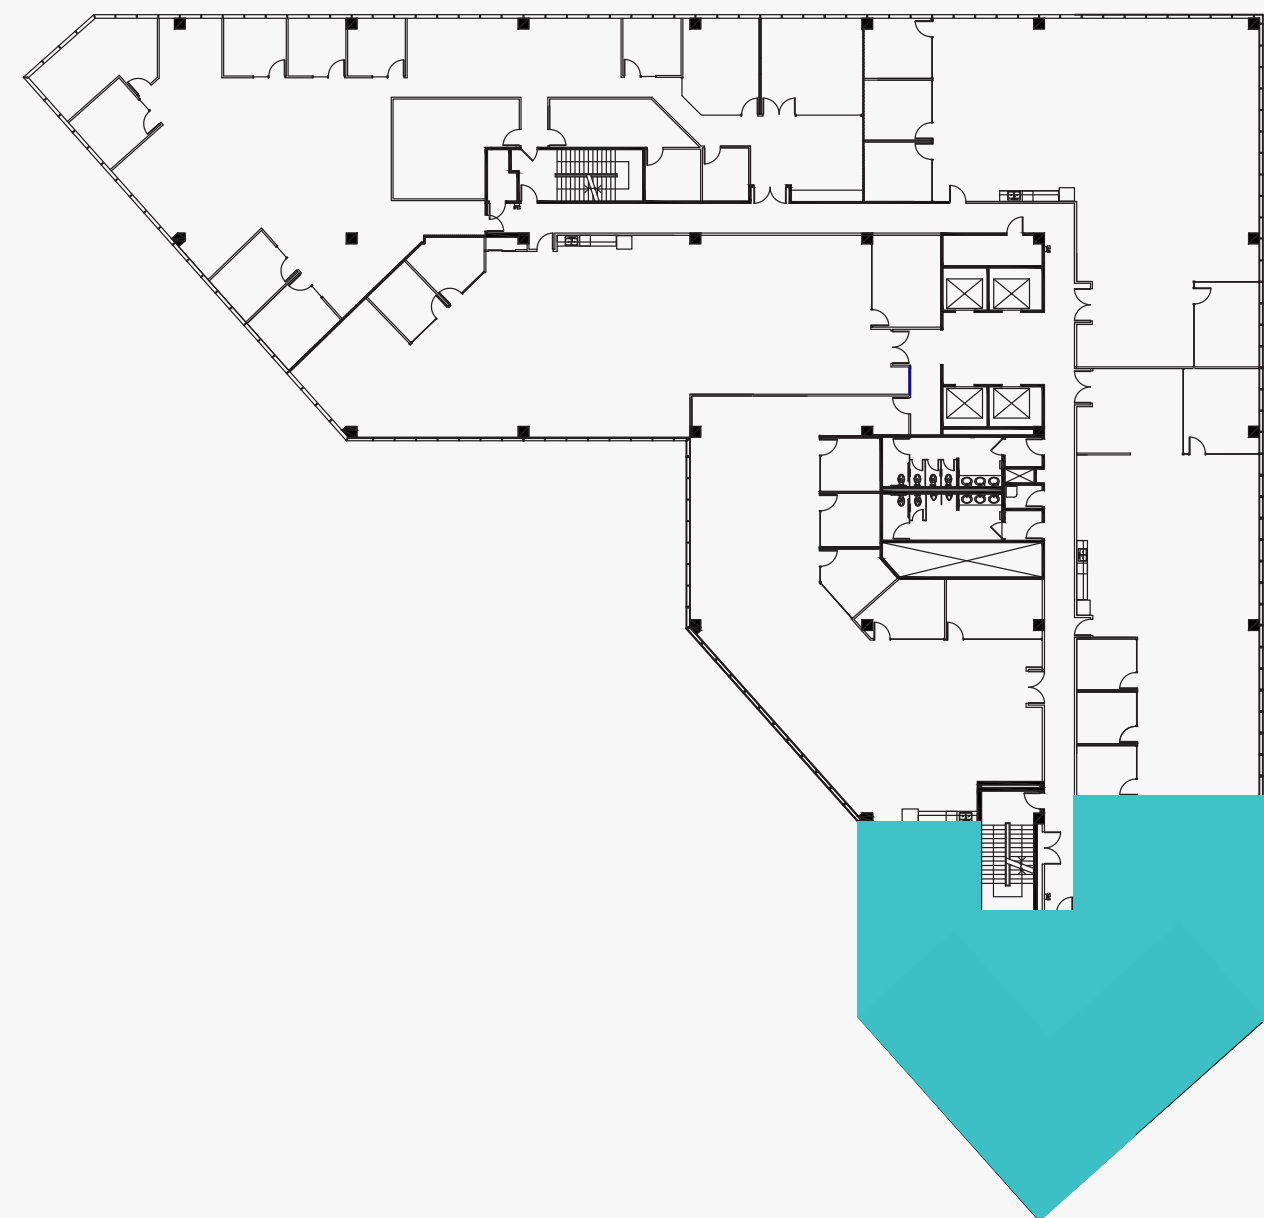

For leasing information please contact:

Tom Sheets

310.525.1919

tom.sheets@cushwake.com

Quint Carroll

310.525.1931

quint.carroll@cushwake.com