



SUITE: 680

RSF: 5,181

AS-BUILT CONFIGURATION

OFFICES.....	8
RECEPTION.....	1
CONFERENCE ROOMS.....	2
KITCHEN/BREAKOUT	2
OPEN WORK AREA.....	TBD

KEY PLAN

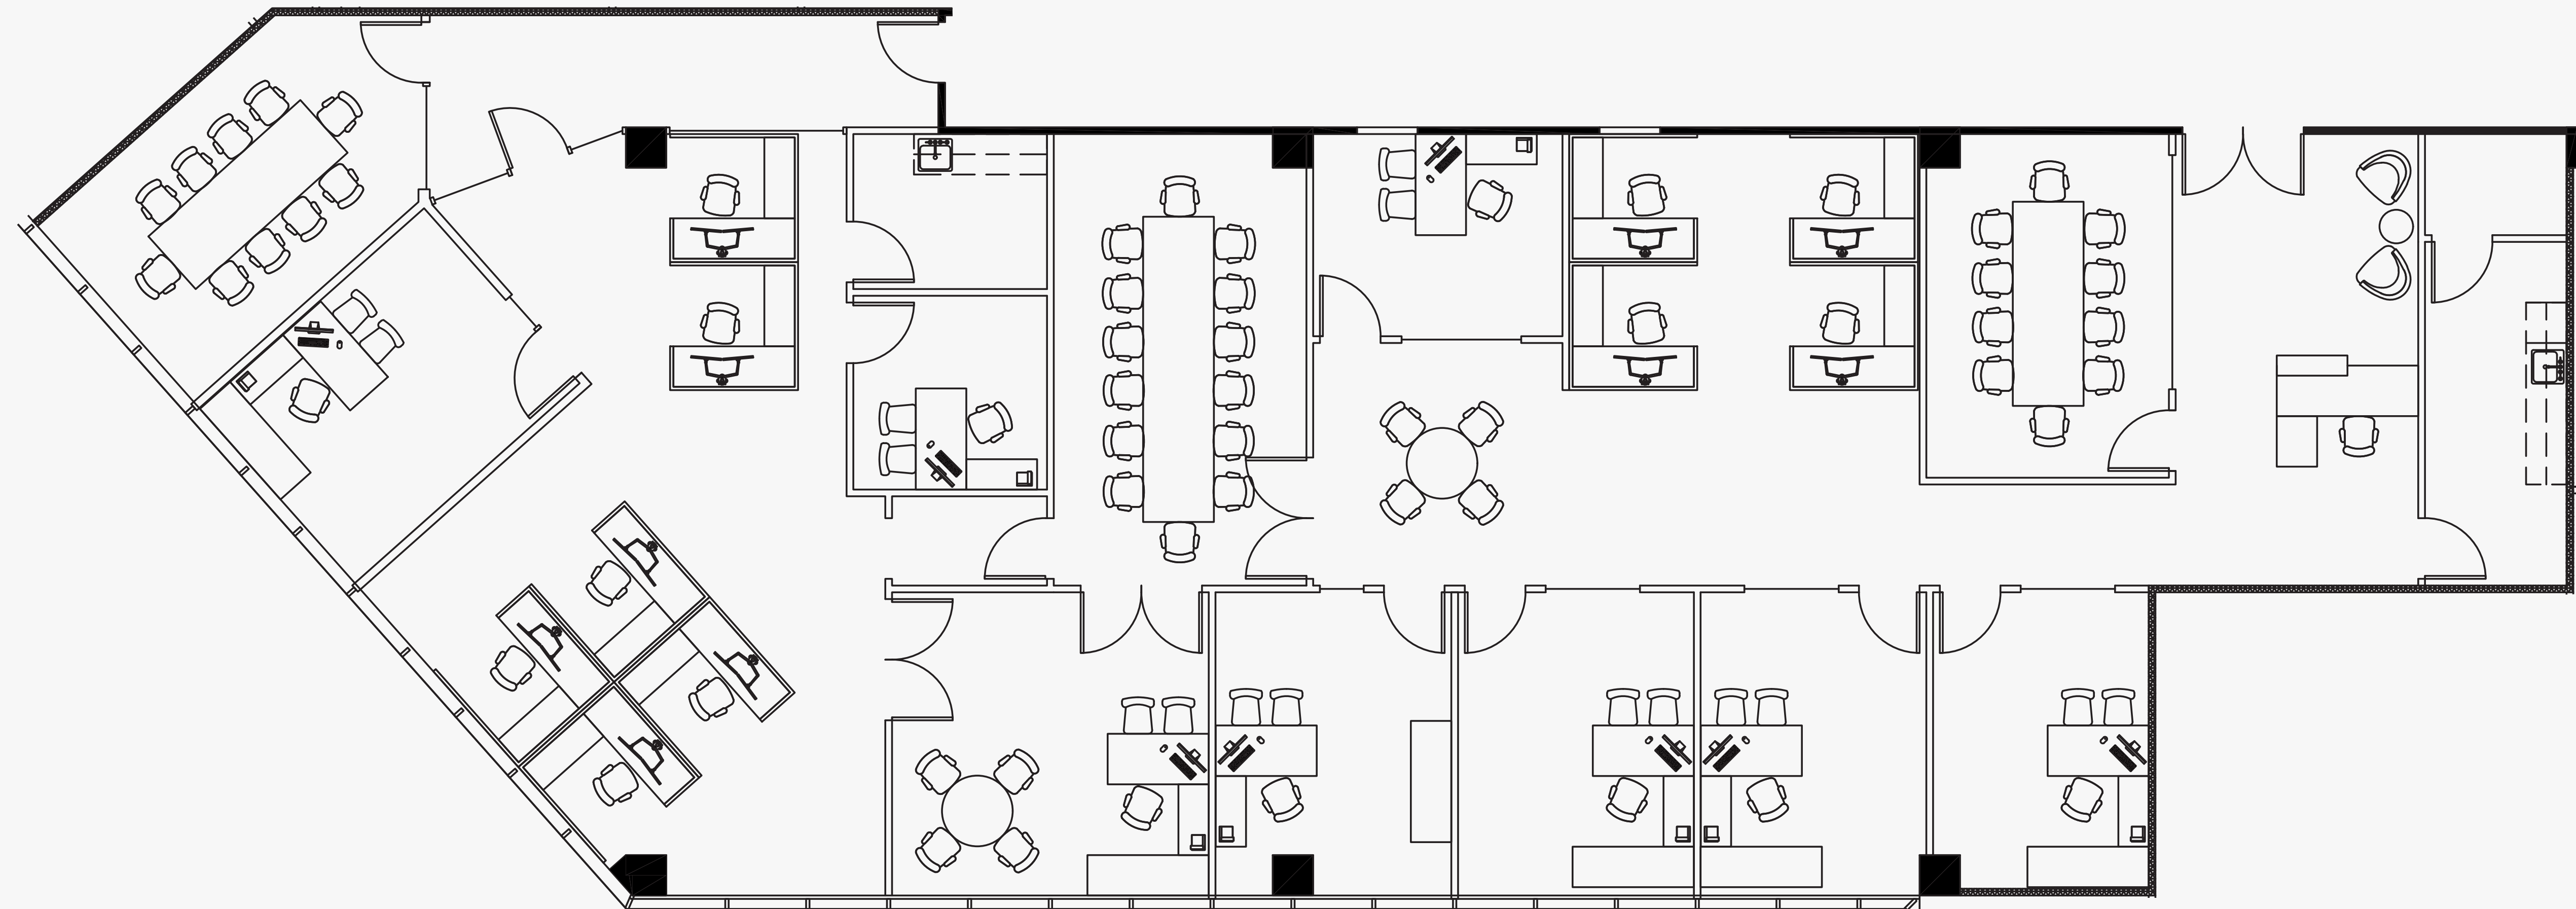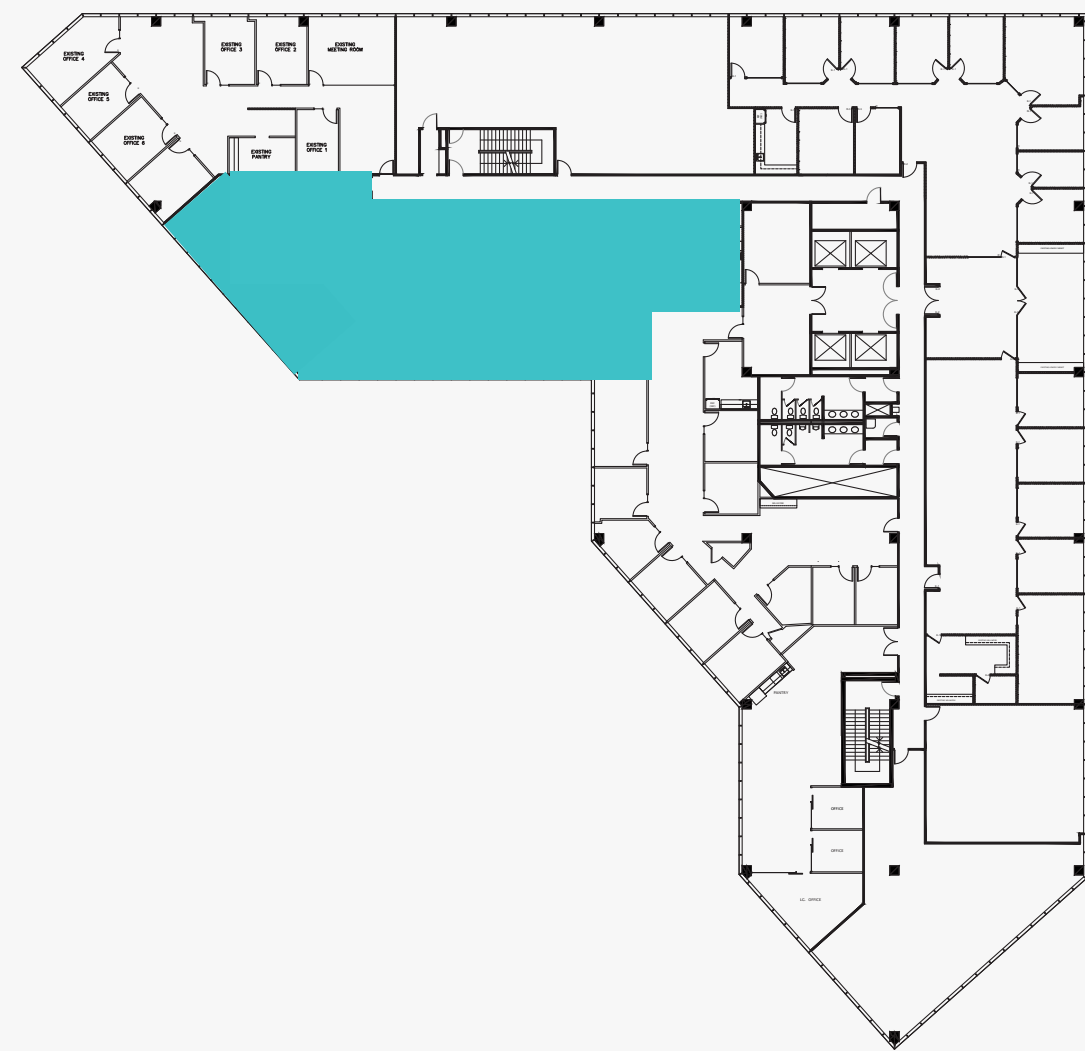

For leasing information please contact:

Tom Sheets	Quint Carroll
310.525.1919	310.525.1931
tom.sheets@cushwake.com	quint.carroll@cushwake.com