
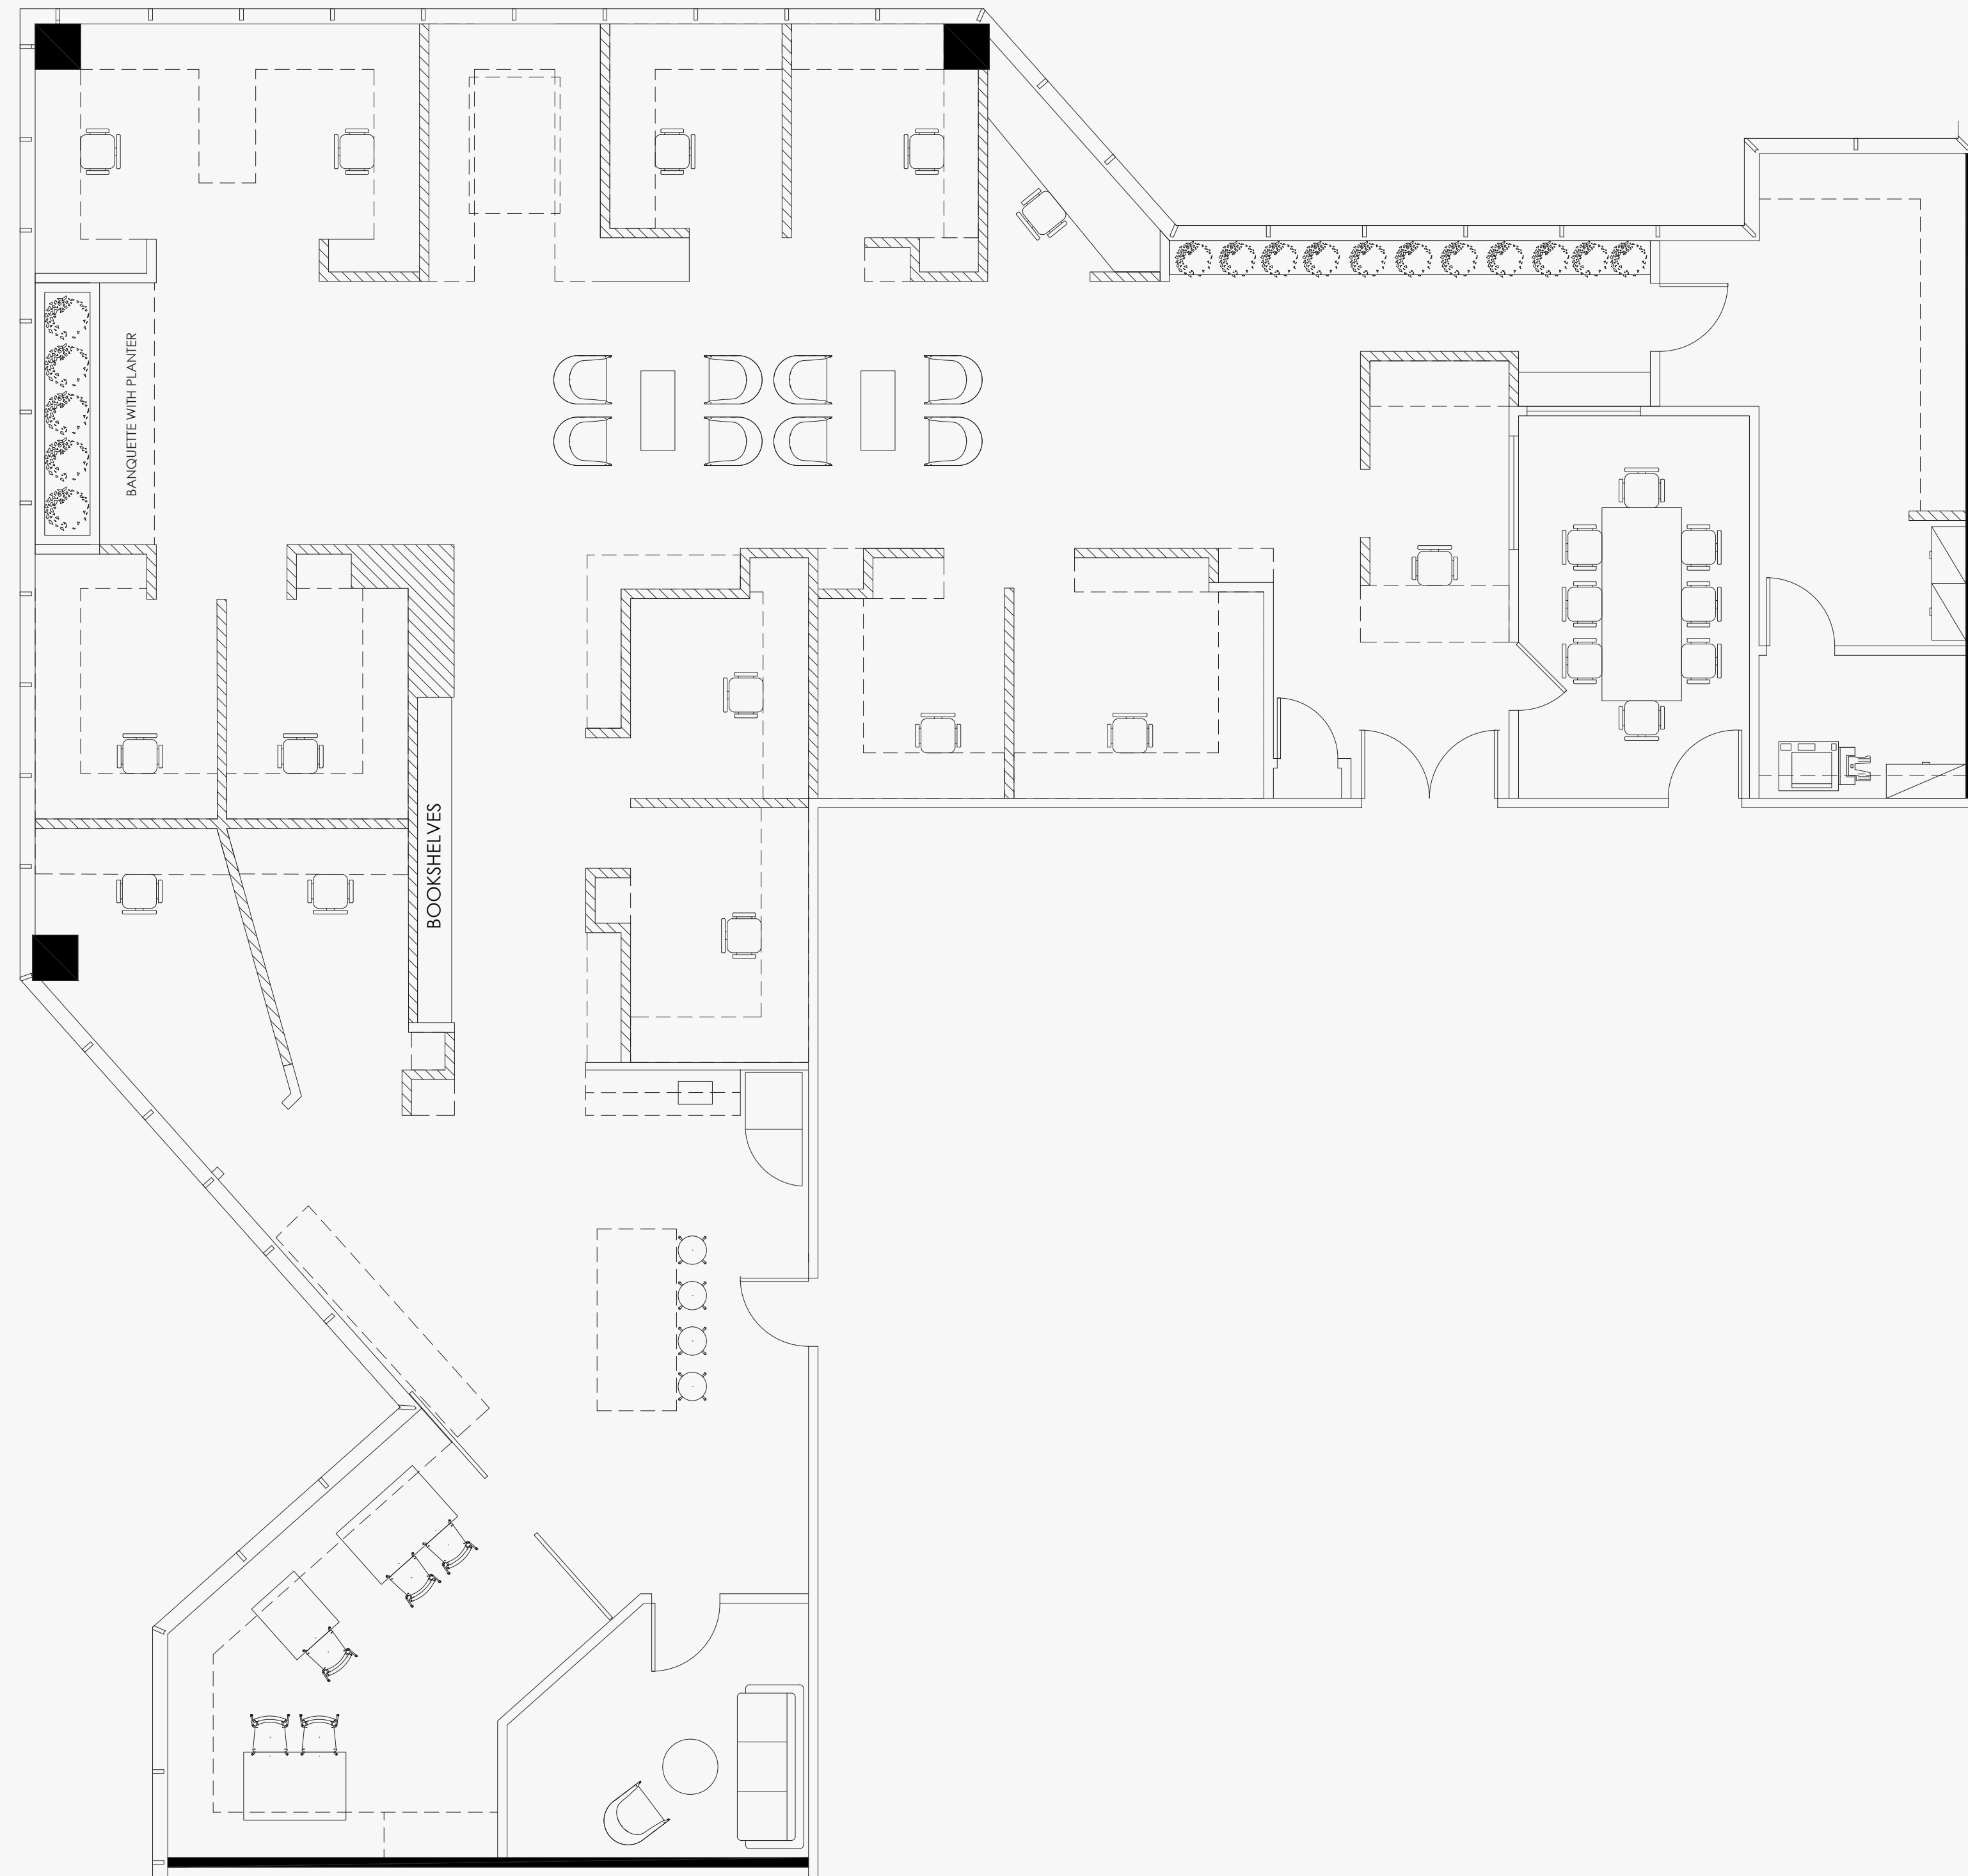


## AS-BUILT CONFIGURATION

OFFICES.....	-
RECEPTION.....	1
CONFERENCE ROOMS.....	1
KITCHEN/BREAKOUT .....	1
OPEN WORK AREA.....	+/- 13

## KEY PLAN

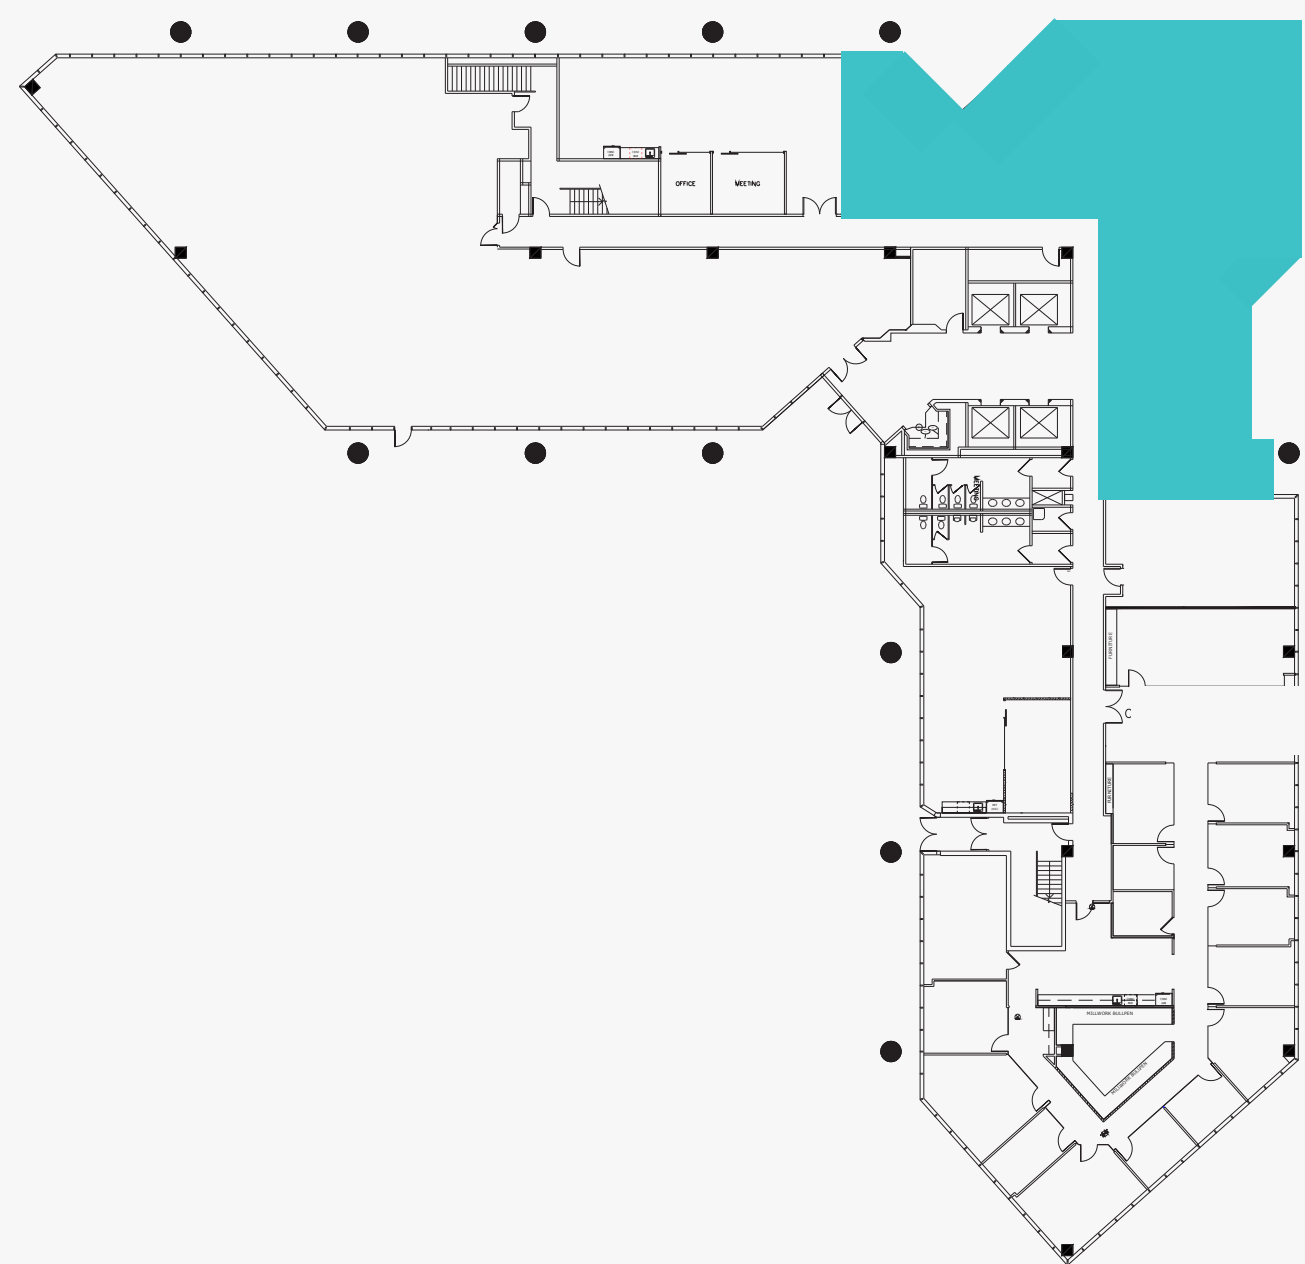

For leasing information please contact:

Tom Sheets  
310.525.1919

Quint Carroll  
310.525.1931

Jillian Solberg  
310.556.1805

tom.sheets@cushwake.com

quint.carroll@cushwake.com

jillian.solberg@cushwake.com