
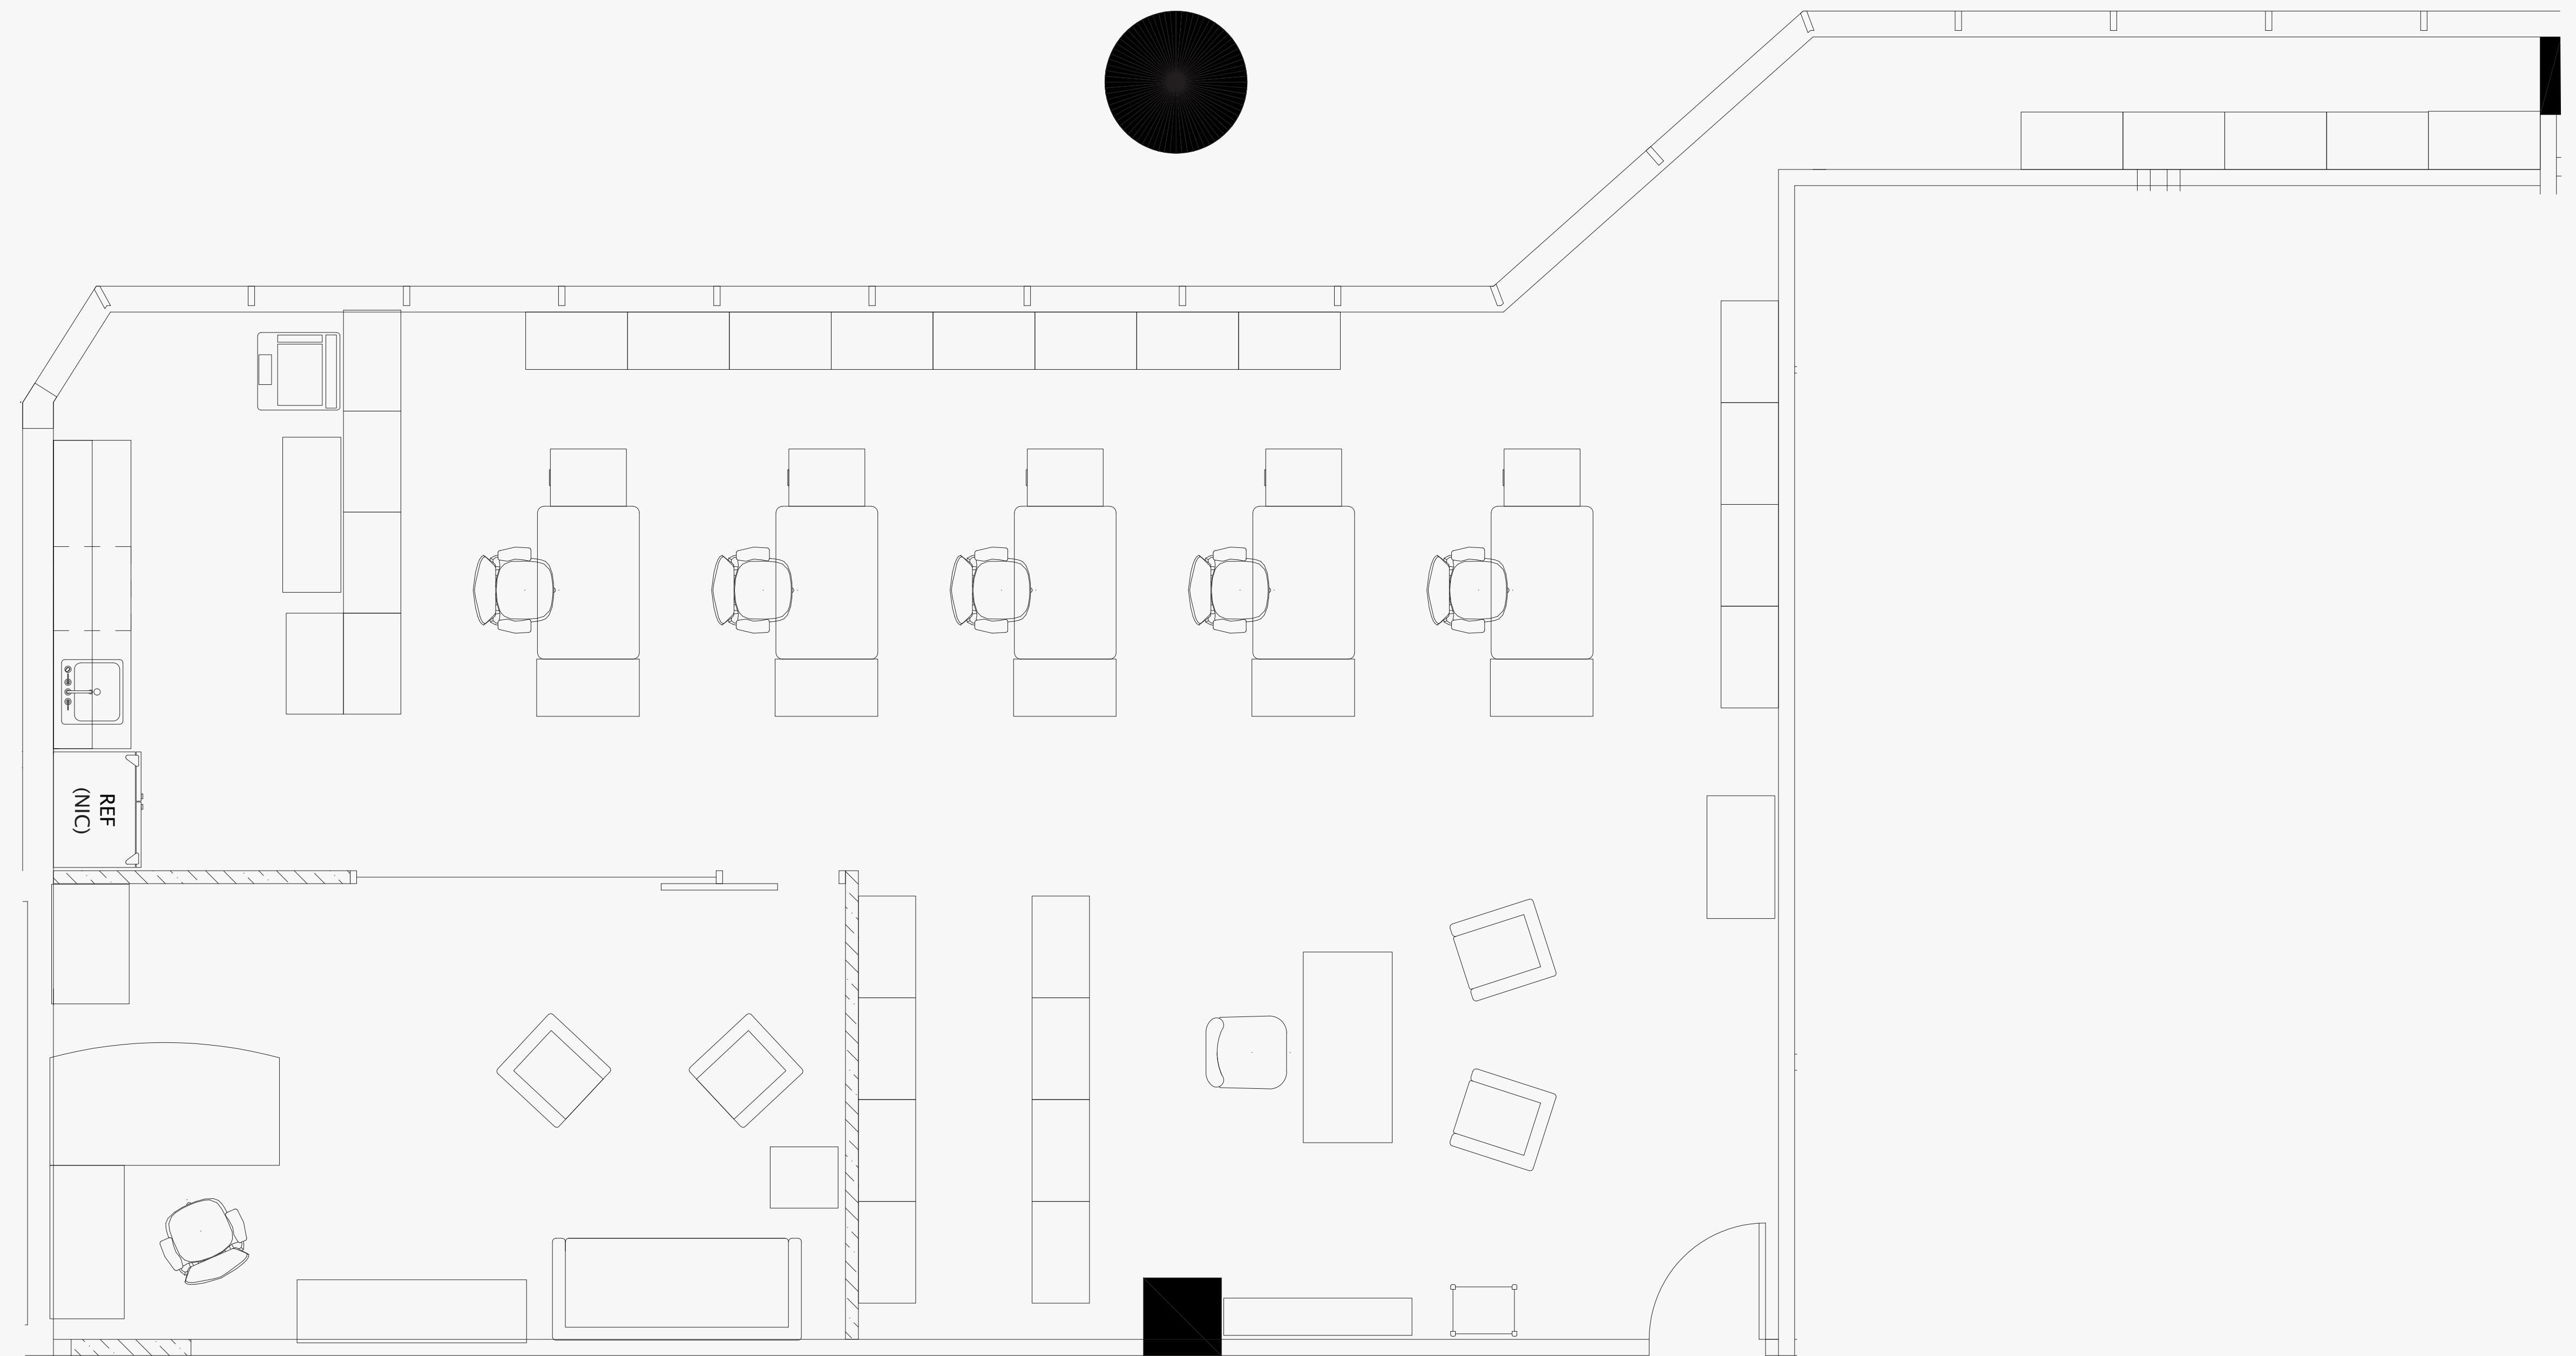


AS-BUILT CONFIGURATION

OFFICES.....	1
RECEPTION.....	1
CONFERENCE ROOMS.....	N/A
KITCHEN/BREAKOUT	1
OPEN WORK AREA.....	+/- 5

KEY PLAN

FURNITURE AND APPLIANCES NOT INCLUDED

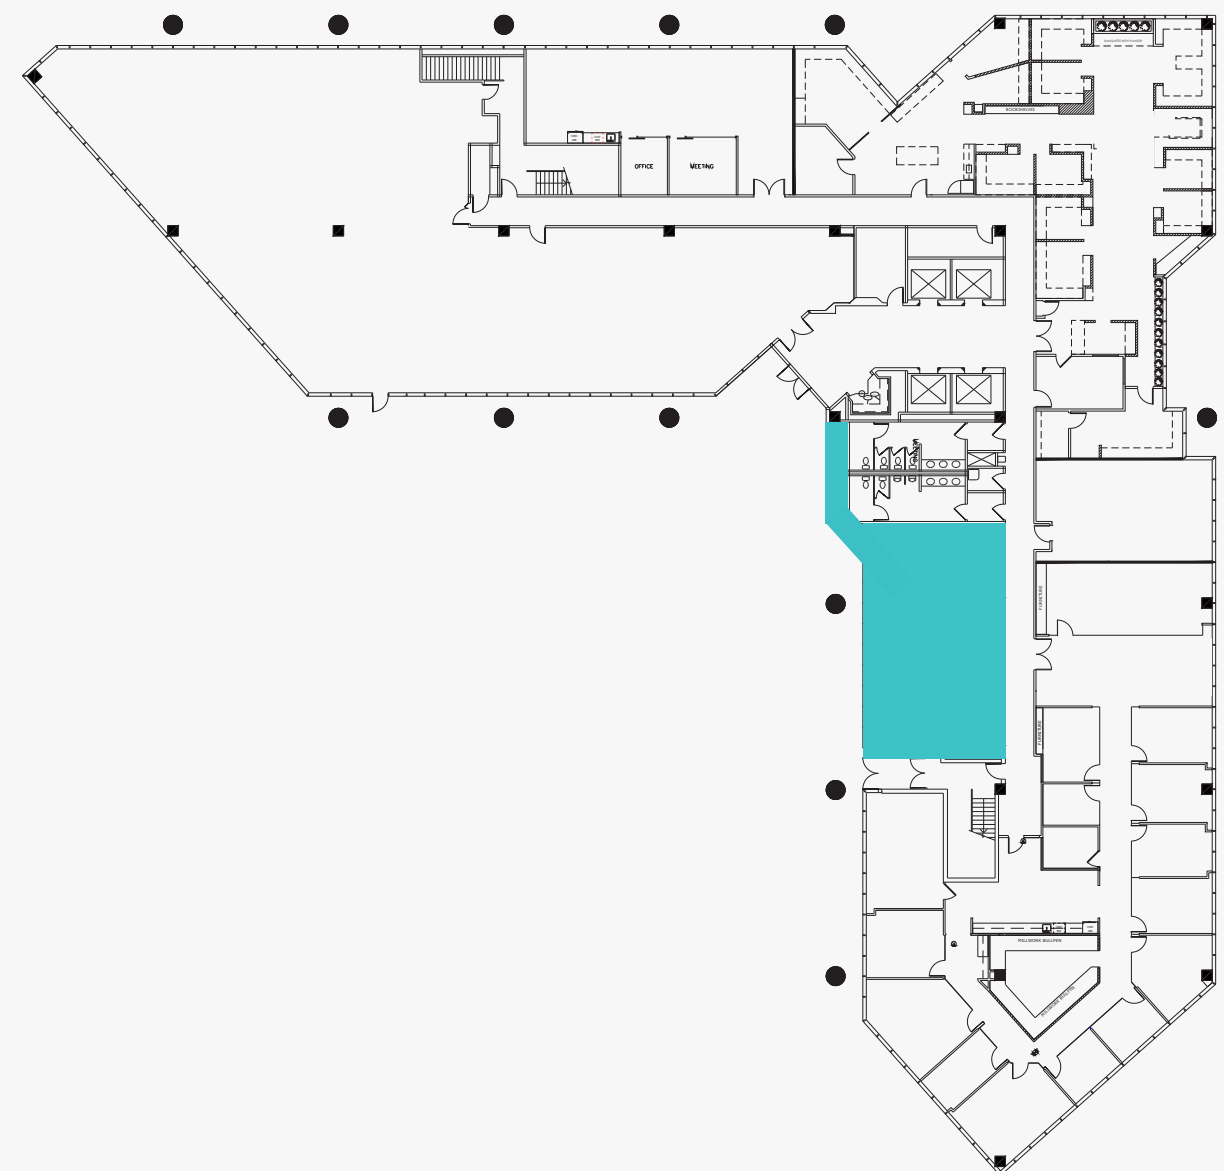

For leasing information please contact:

Tom Sheets | Lic. 01252183

Quint Carroll | Lic. 01914692

310363.4943

310.363.4973

tom.sheets@cbre.com

quint.carroll@cbre.com