
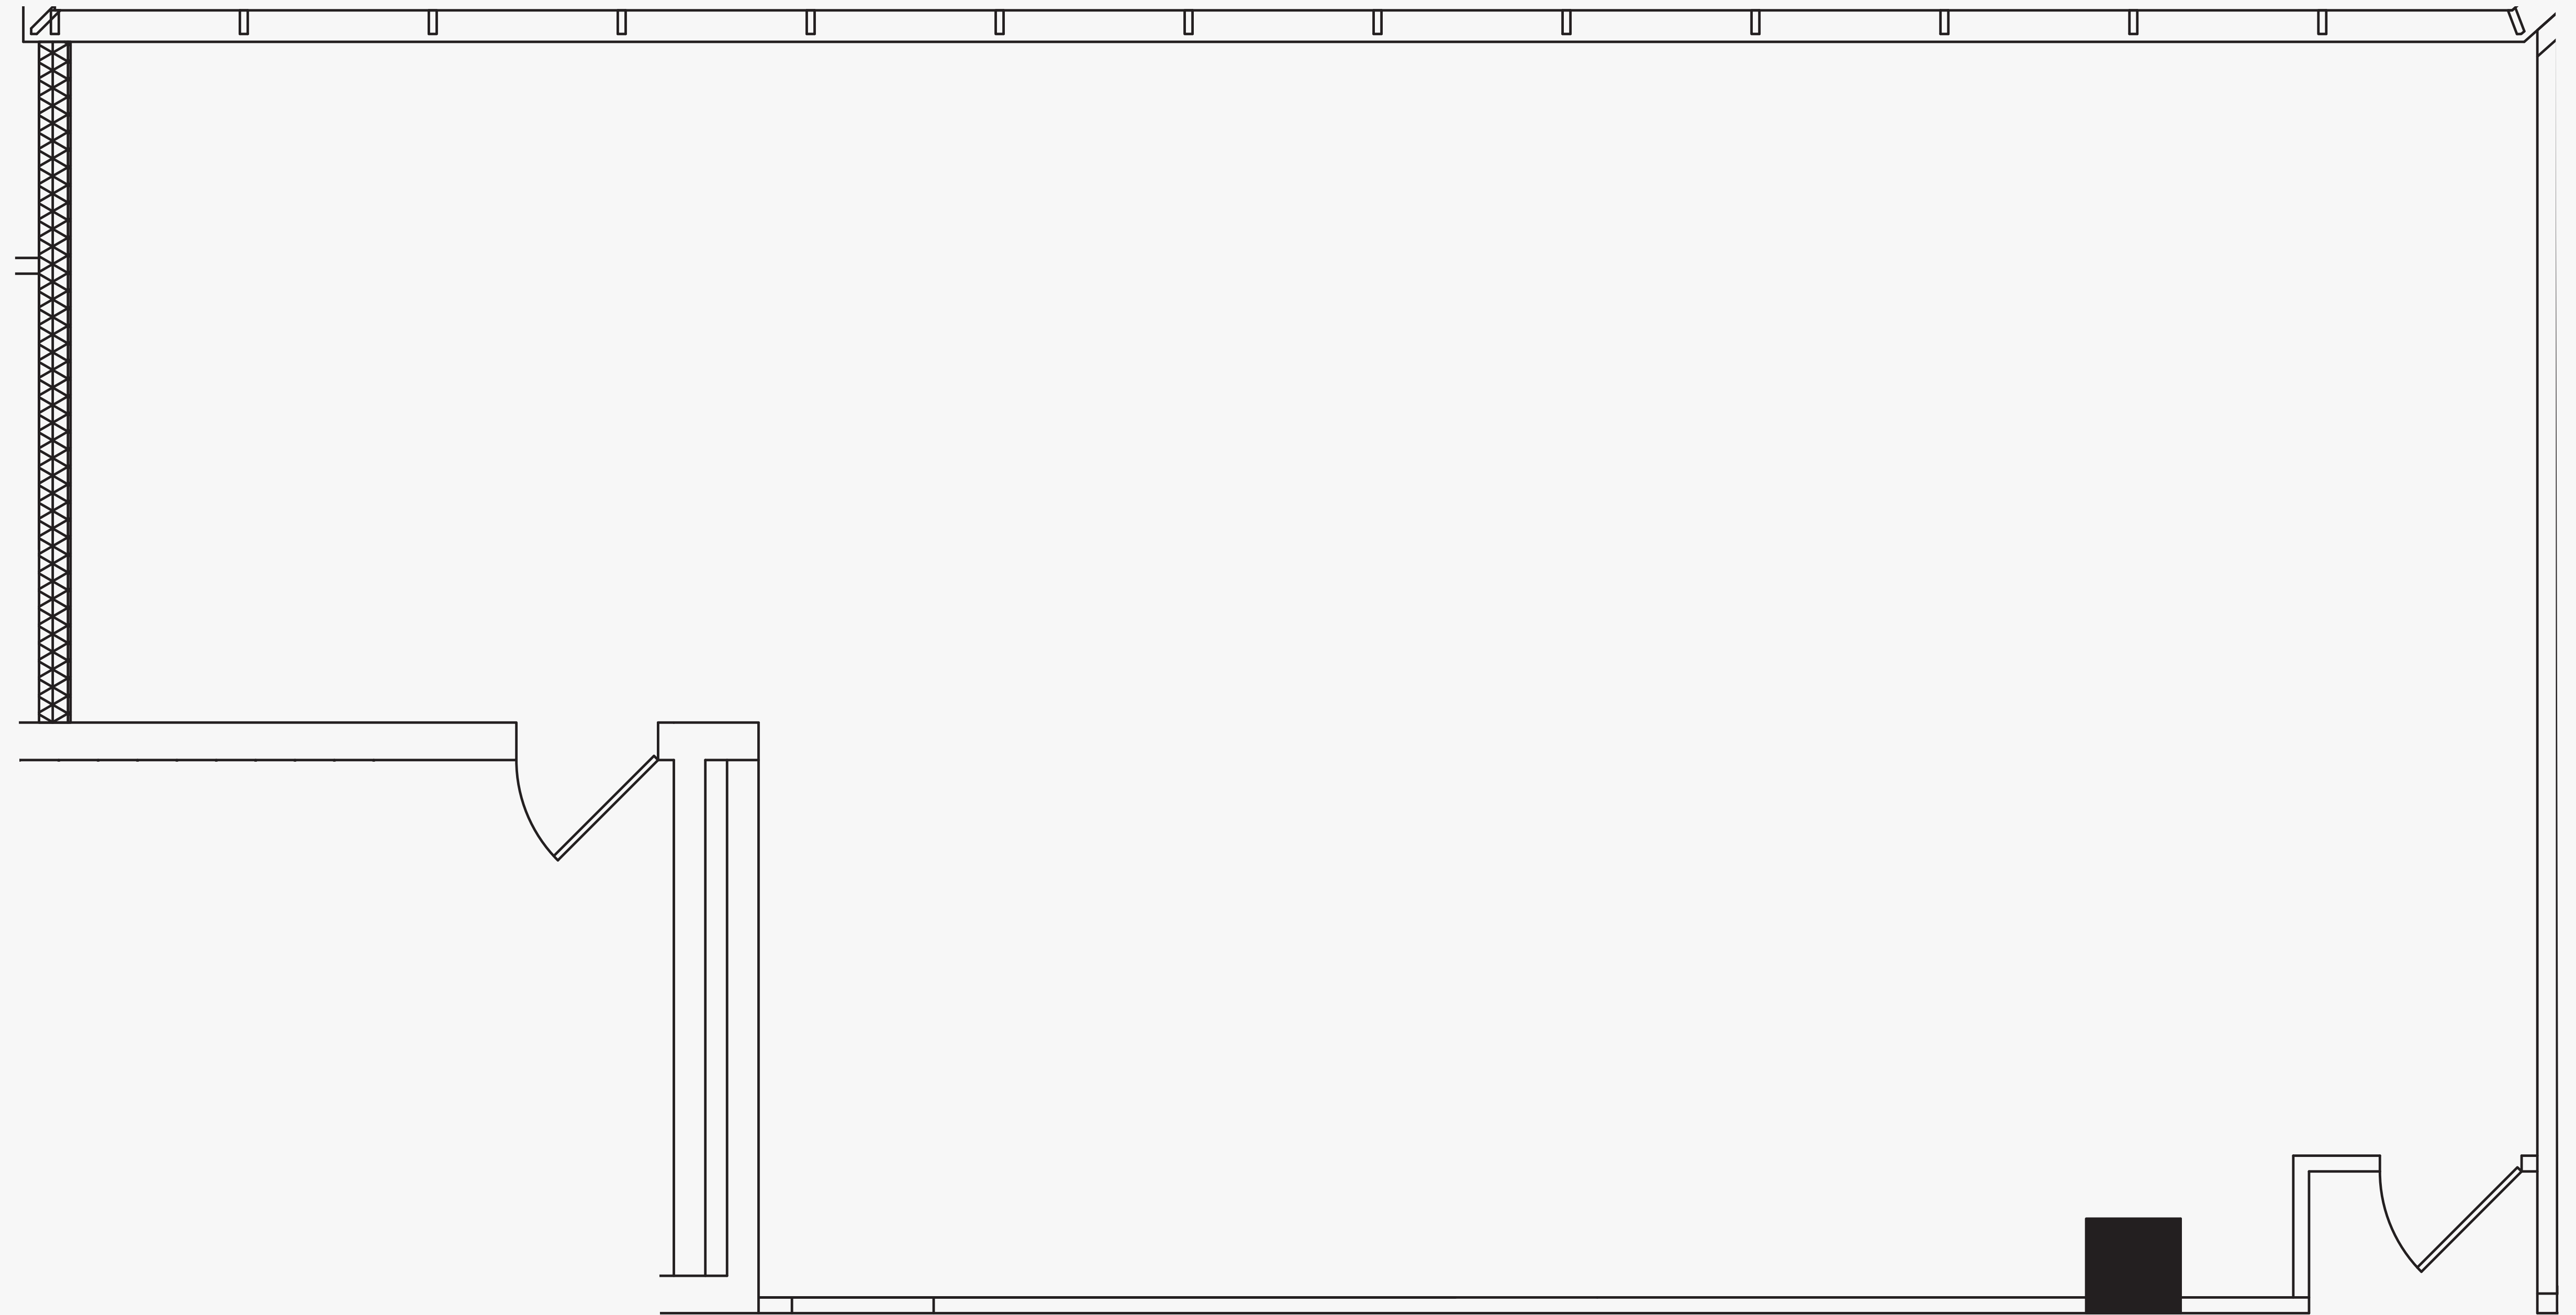


AS-BUILT CONFIGURATION

- OFFICES..... N/A
- RECEPTION..... N/A
- CONFERENCE ROOMS..... N/A
- KITCHEN/BREAKOUT N/A
- OPEN WORK AREA..... N/A

KEY PLAN

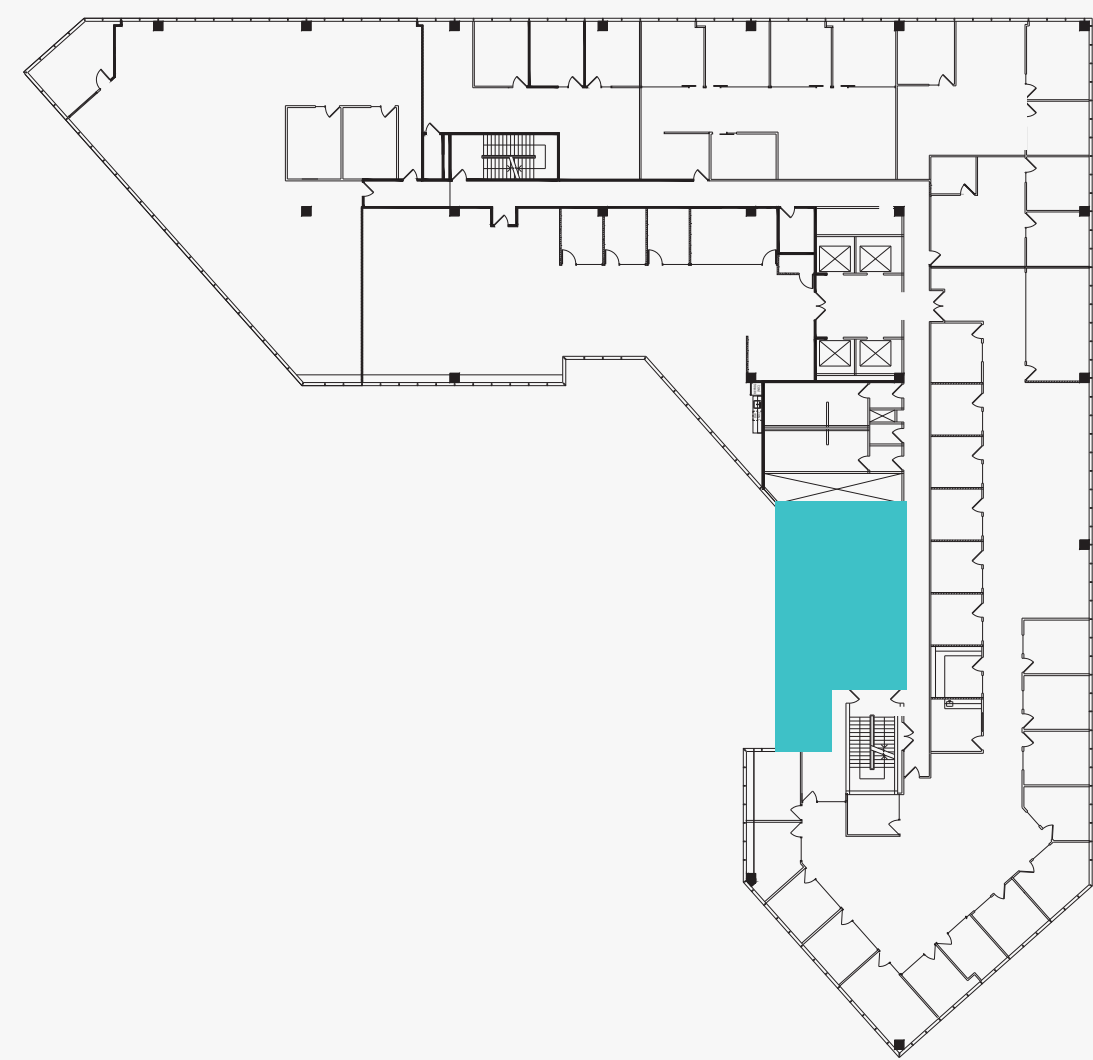

For leasing information please contact:

Tom Sheets | Lic. 01252183 Quint Carroll | Lic. 01914692

310.363.4943 310.363.4973

tom.sheets@cbre.com quint.carroll@cbre.com