



SUITE: 500

RSF: 4,648

AS-BUILT CONFIGURATION

OFFICES.....	6
RECEPTION.....	1
CONFERENCE ROOMS.....	1
KITCHEN/BREAKOUT	1
OPEN WORK AREA.....	+/-21

KEY PLAN

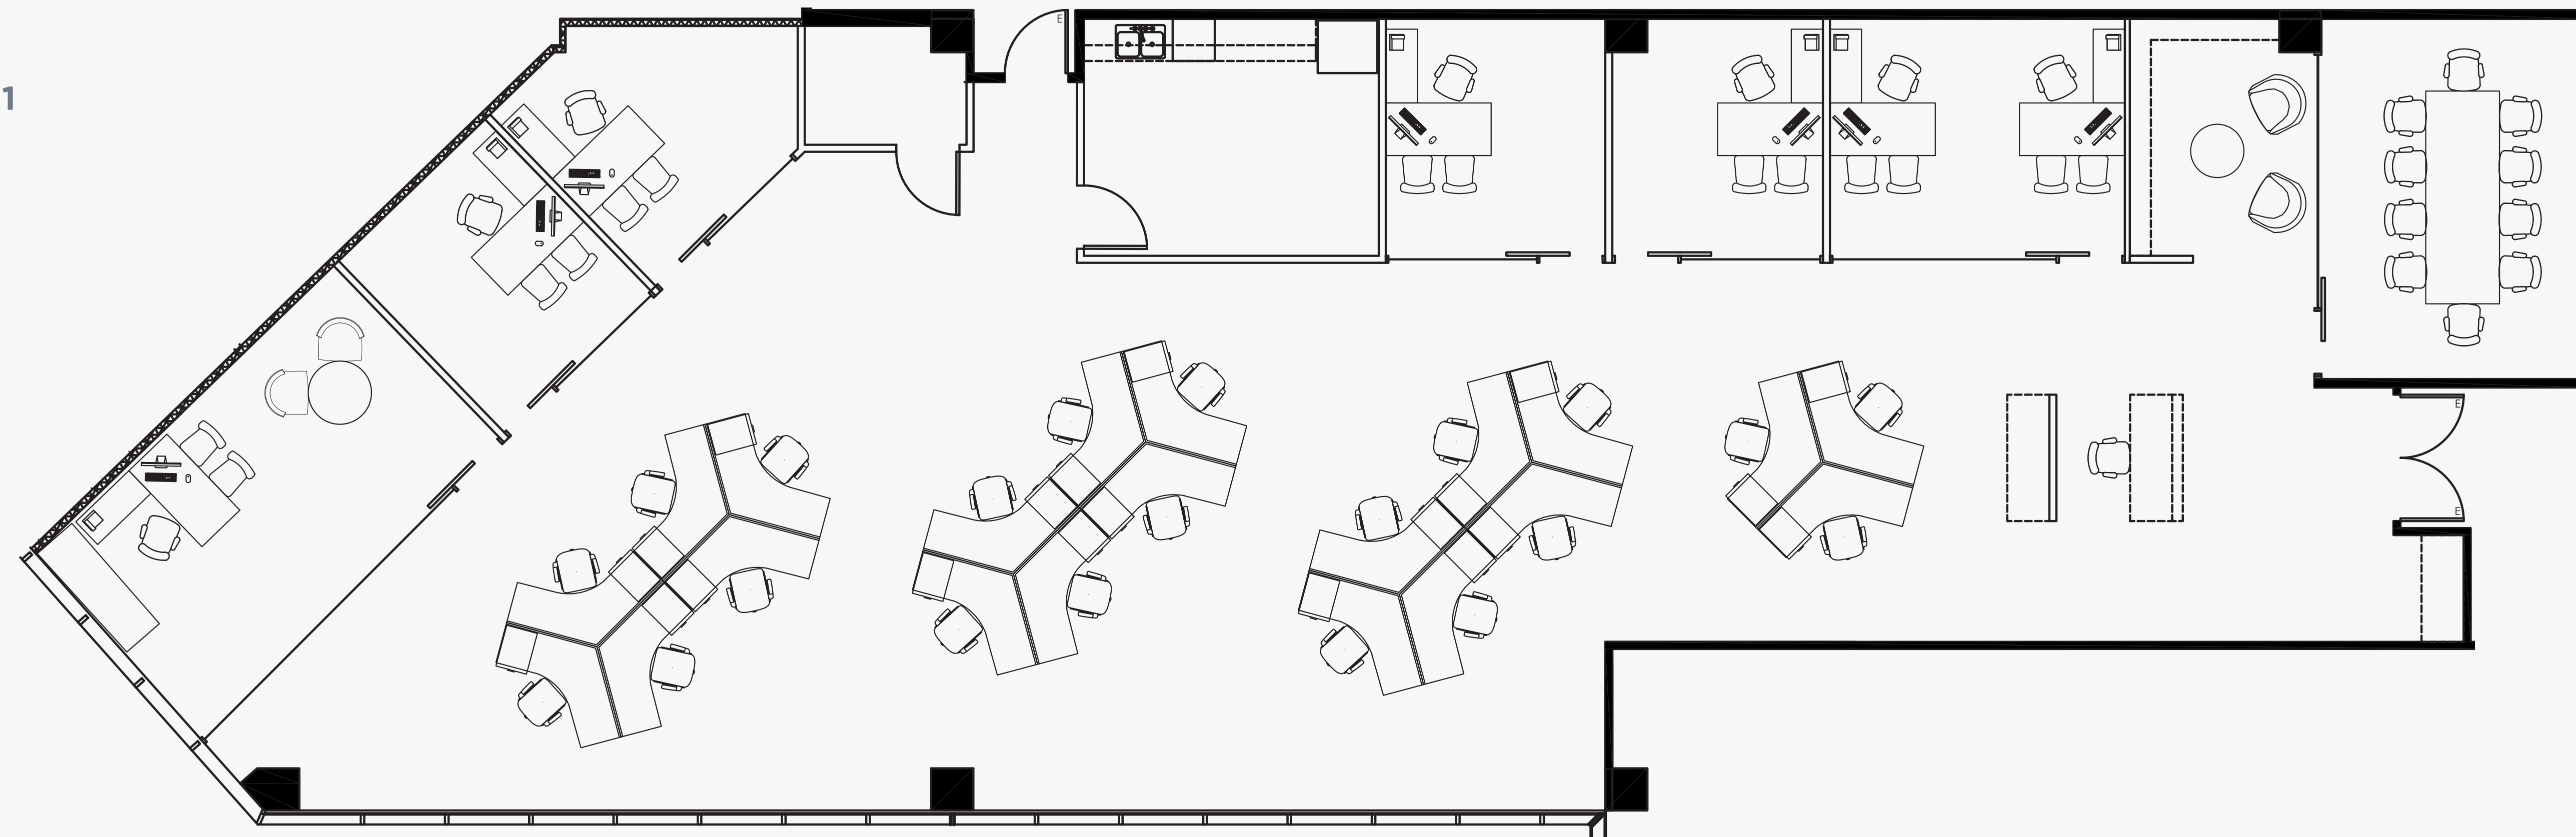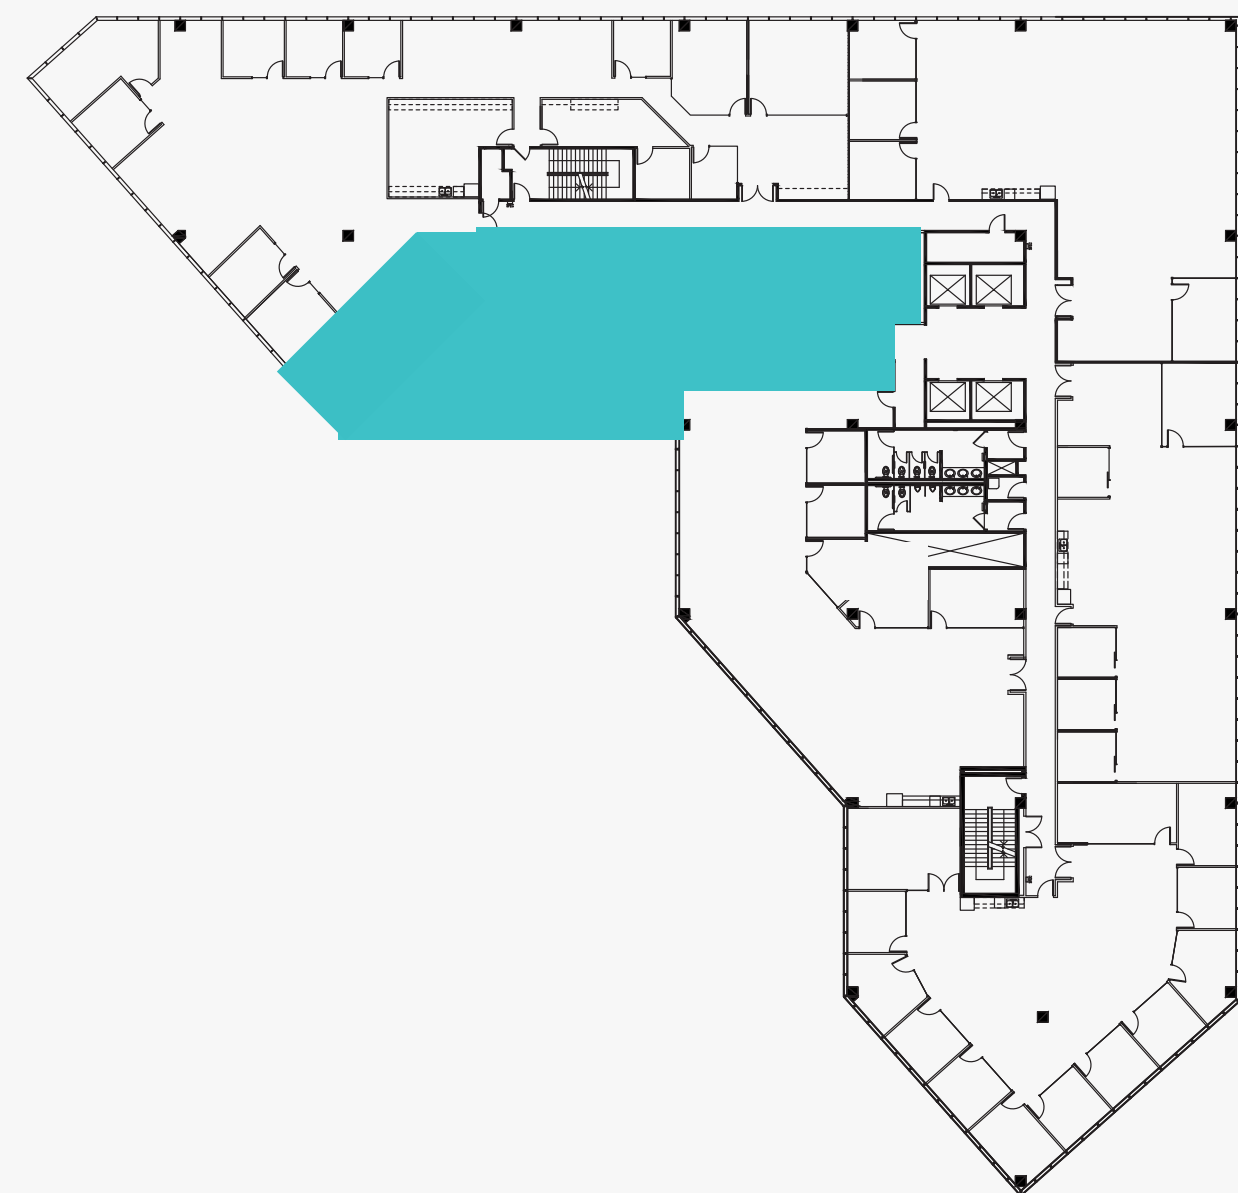

For leasing information please contact:

Tom Sheets | Lic. 01252183

310.363.4943

tom.sheets@cbre.com

Quint Carroll | Lic. 01914692

310.363.4973

quint.carroll@cbre.com