
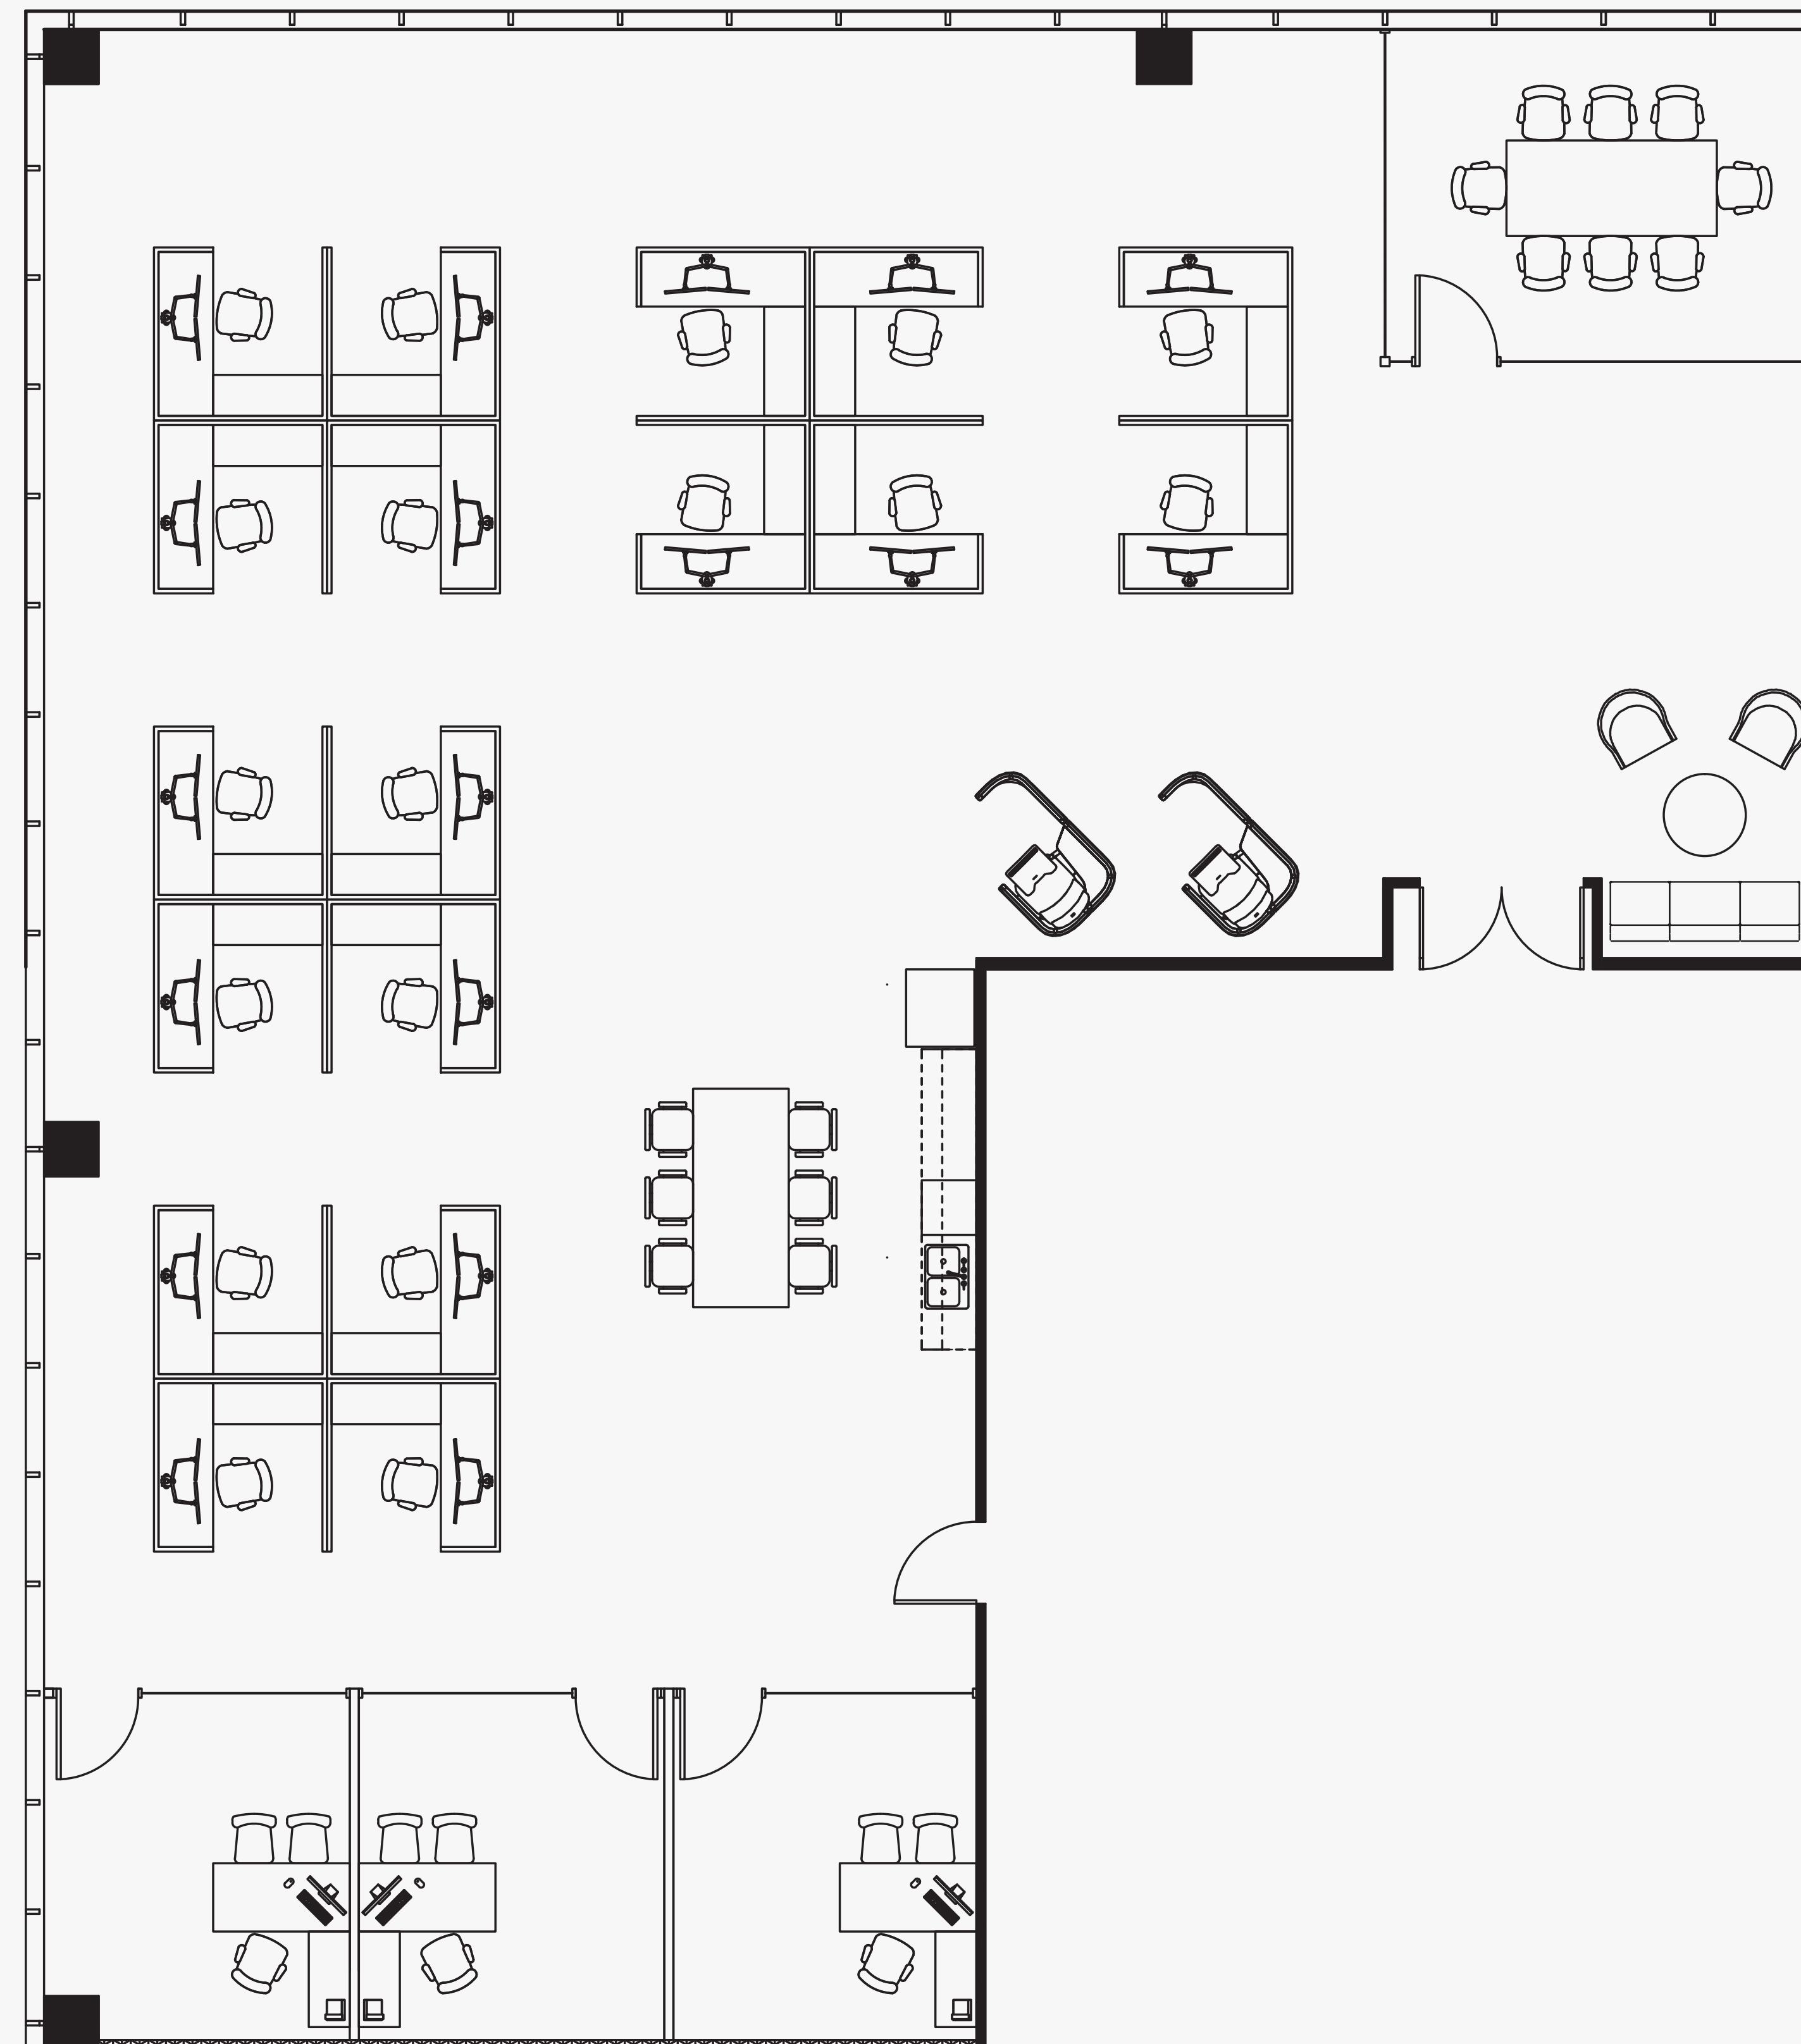


AS-BUILT CONFIGURATION

| | |
|------------------------|--------|
| OFFICES..... | 3 |
| RECEPTION..... | 1 |
| CONFERENCE ROOMS..... | 1 |
| KITCHEN/BREAKOUT | 1 |
| OPEN WORK AREA..... | +/- 18 |

KEY PLAN

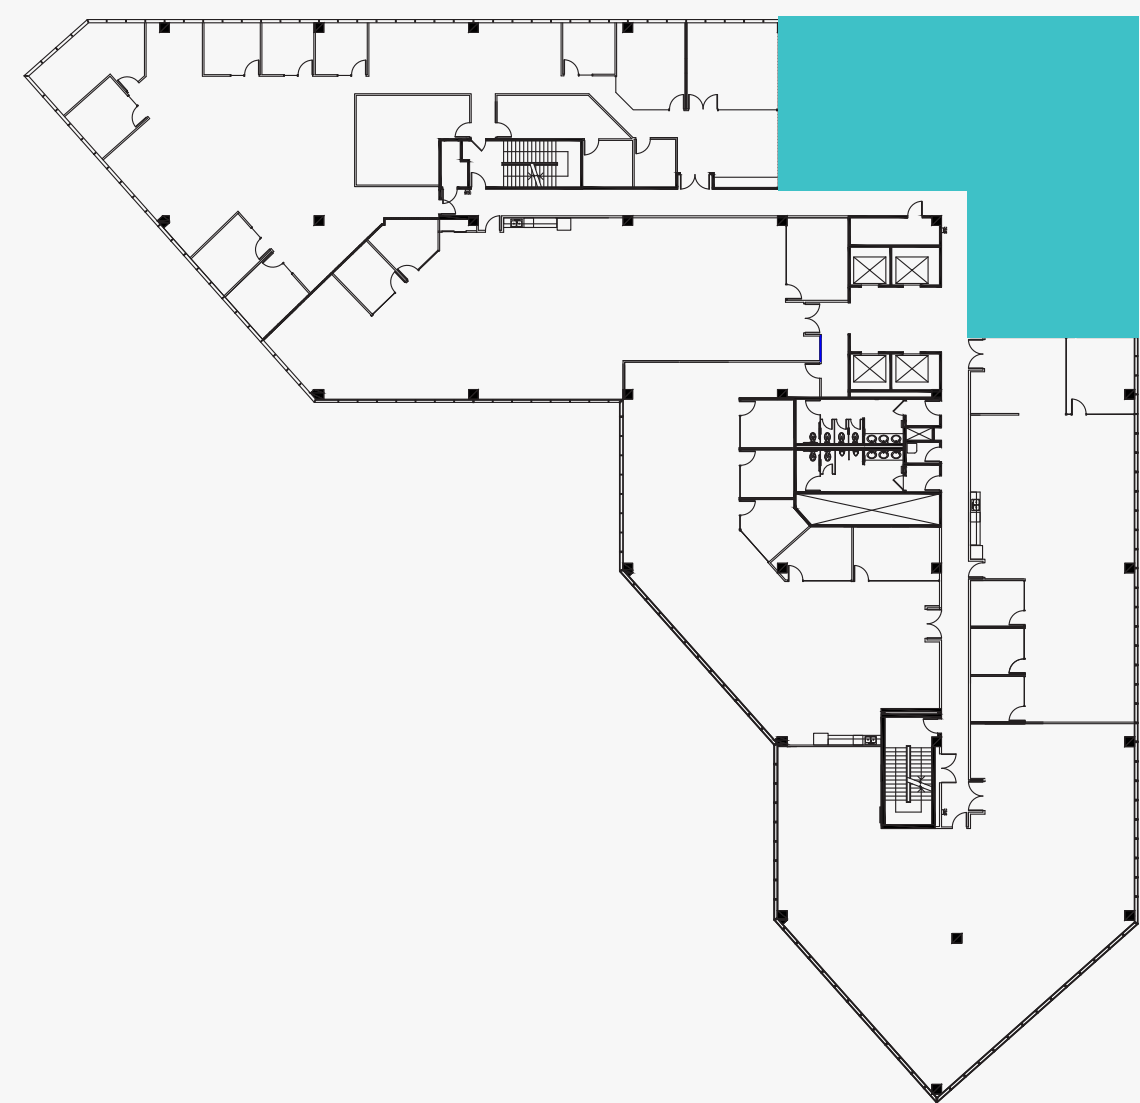

For leasing information please contact:

Tom Sheets | Lic. 01252183

310.363.4943

tom.sheets@cbre.com

Quint Carroll | Lic. 01914692

310.363.4973

quint.carroll@cbre.com