
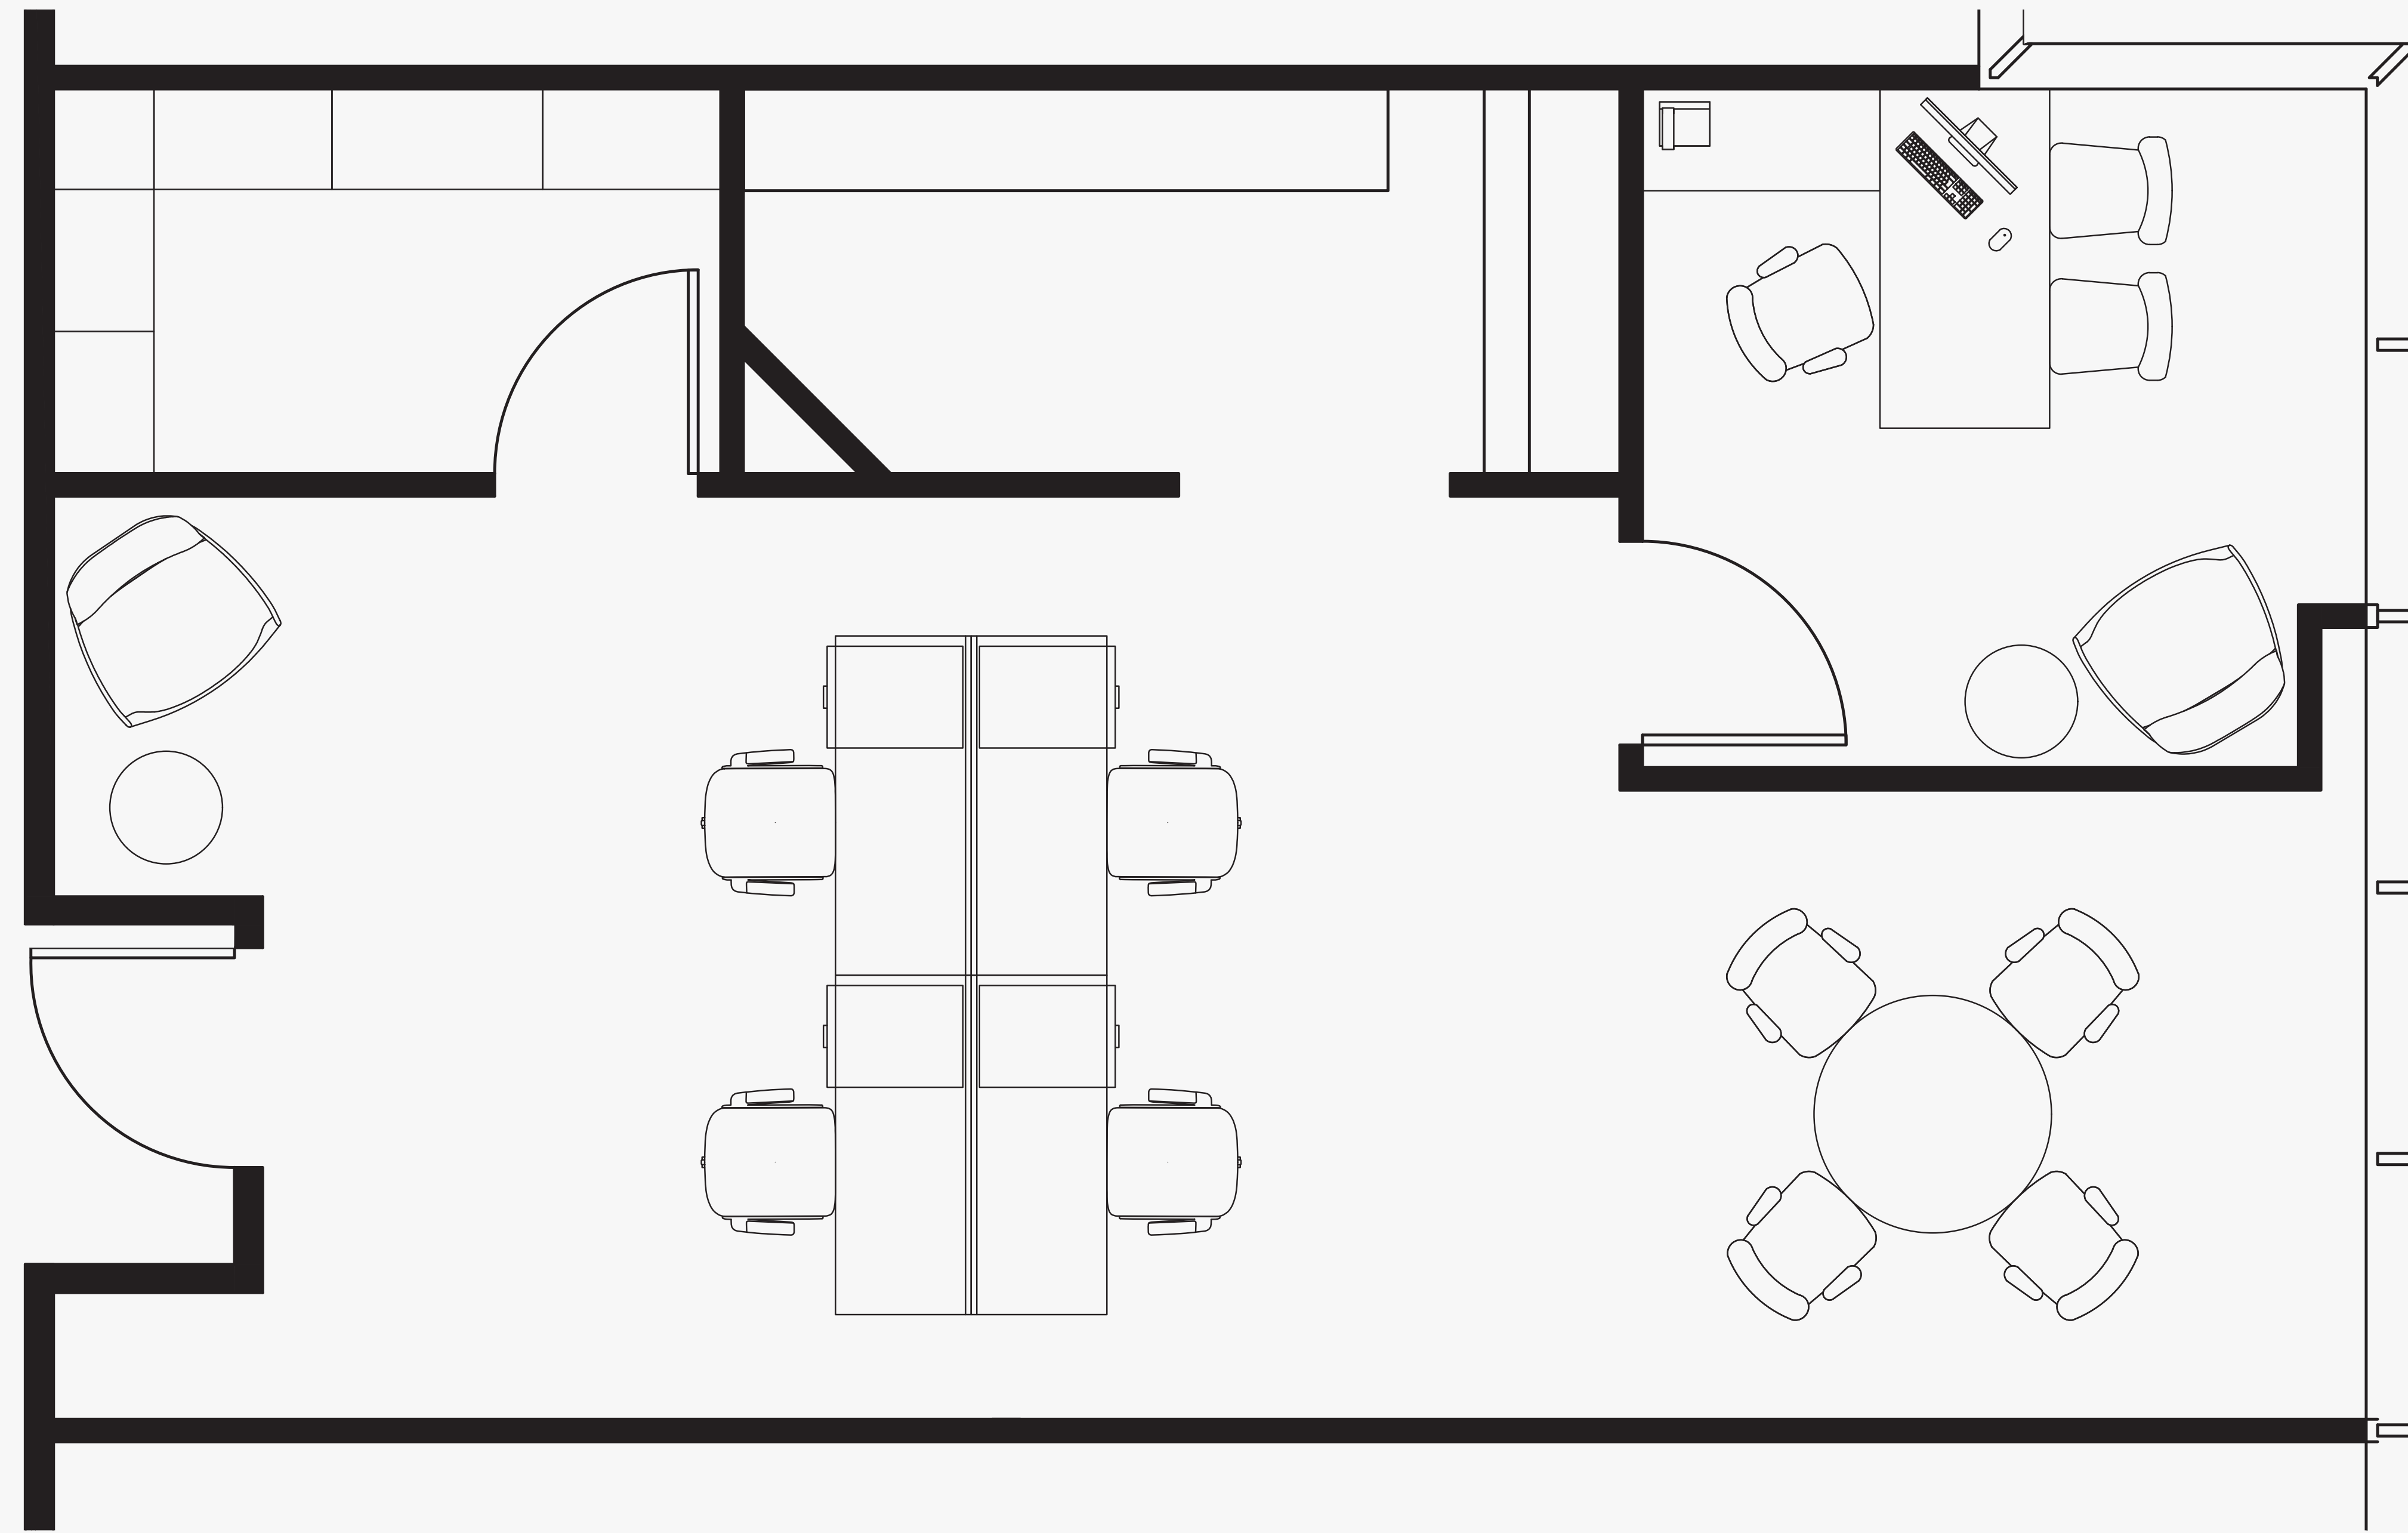


## AS-BUILT CONFIGURATION

OFFICES.....	1
RECEPTION.....	0
CONFERENCE ROOMS.....	0
KITCHEN/BREAKOUT .....	1
OPEN WORK AREA.....	+/-8

## KEY PLAN

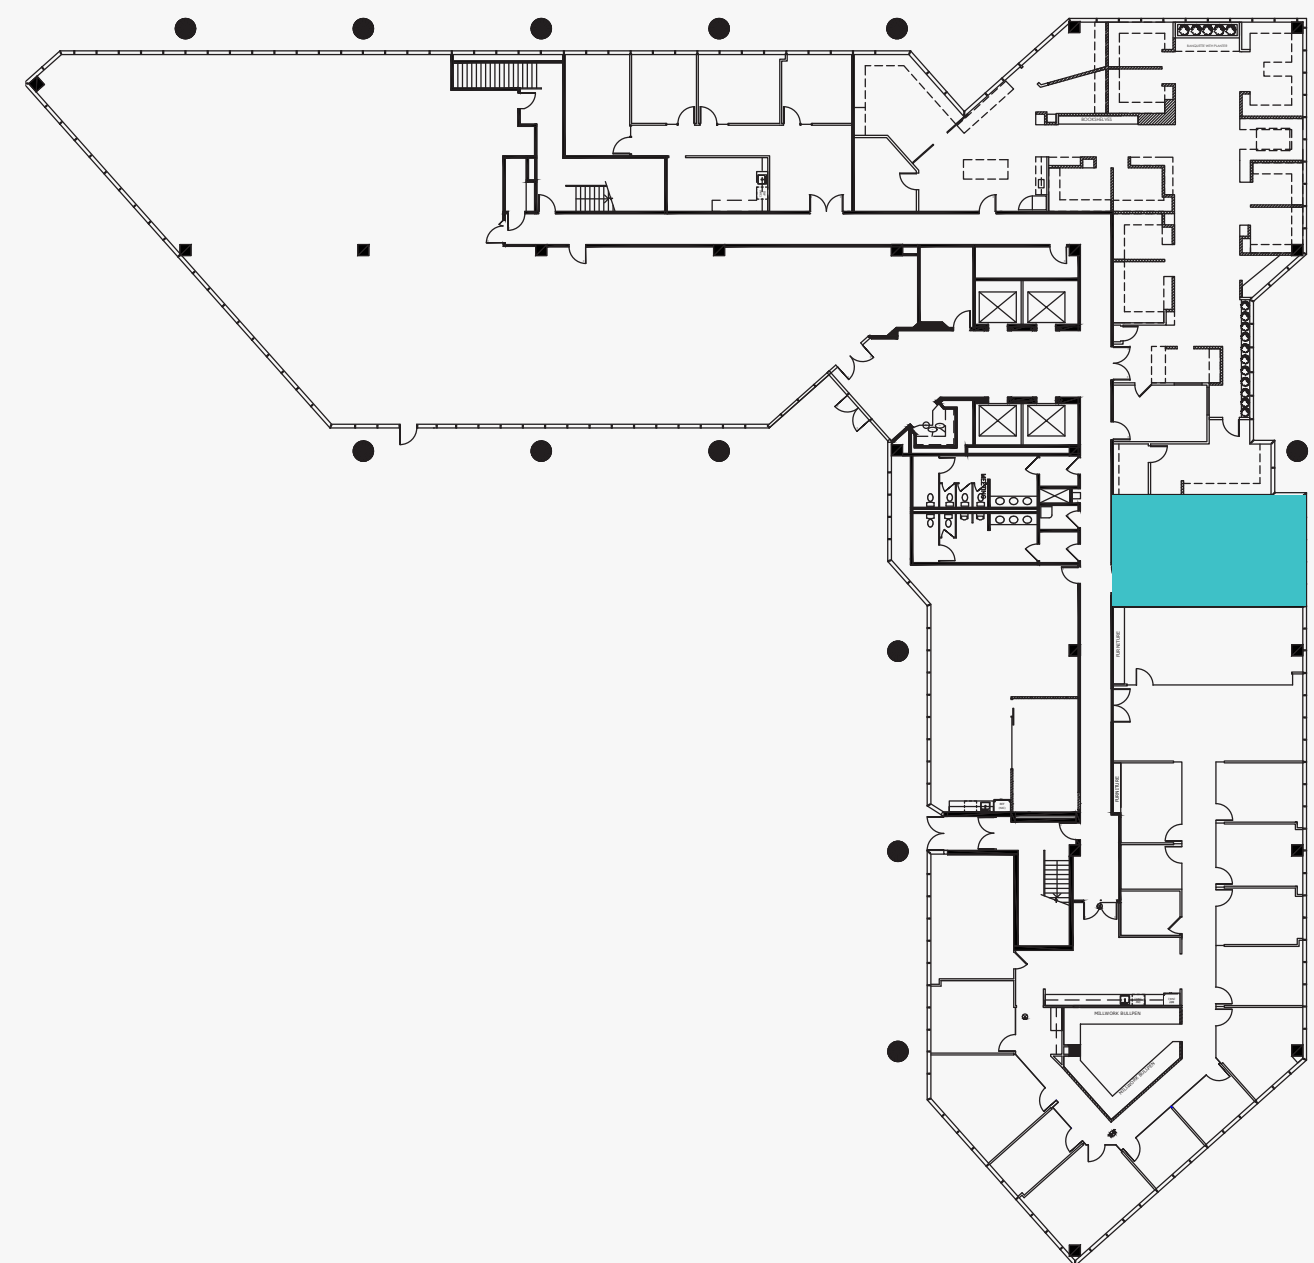

For leasing information please contact:

Tom Sheets | Lic. 01252183  
310.363.4943 | 213.440.0269  
tom.sheets@cbre.com

Quint Carroll | Lic. 01914692  
310.363.4973 | 310.344.2488  
quint.carroll@cbre.com