


AS-BUILT CONFIGURATION

| | |
|------------------------|-----|
| OFFICES..... | 2 |
| RECEPTION..... | 1 |
| CONFERENCE ROOMS..... | 1 |
| KITCHEN/BREAKOUT | 1 |
| OPEN WORK AREA..... | N/A |

KEY PLAN

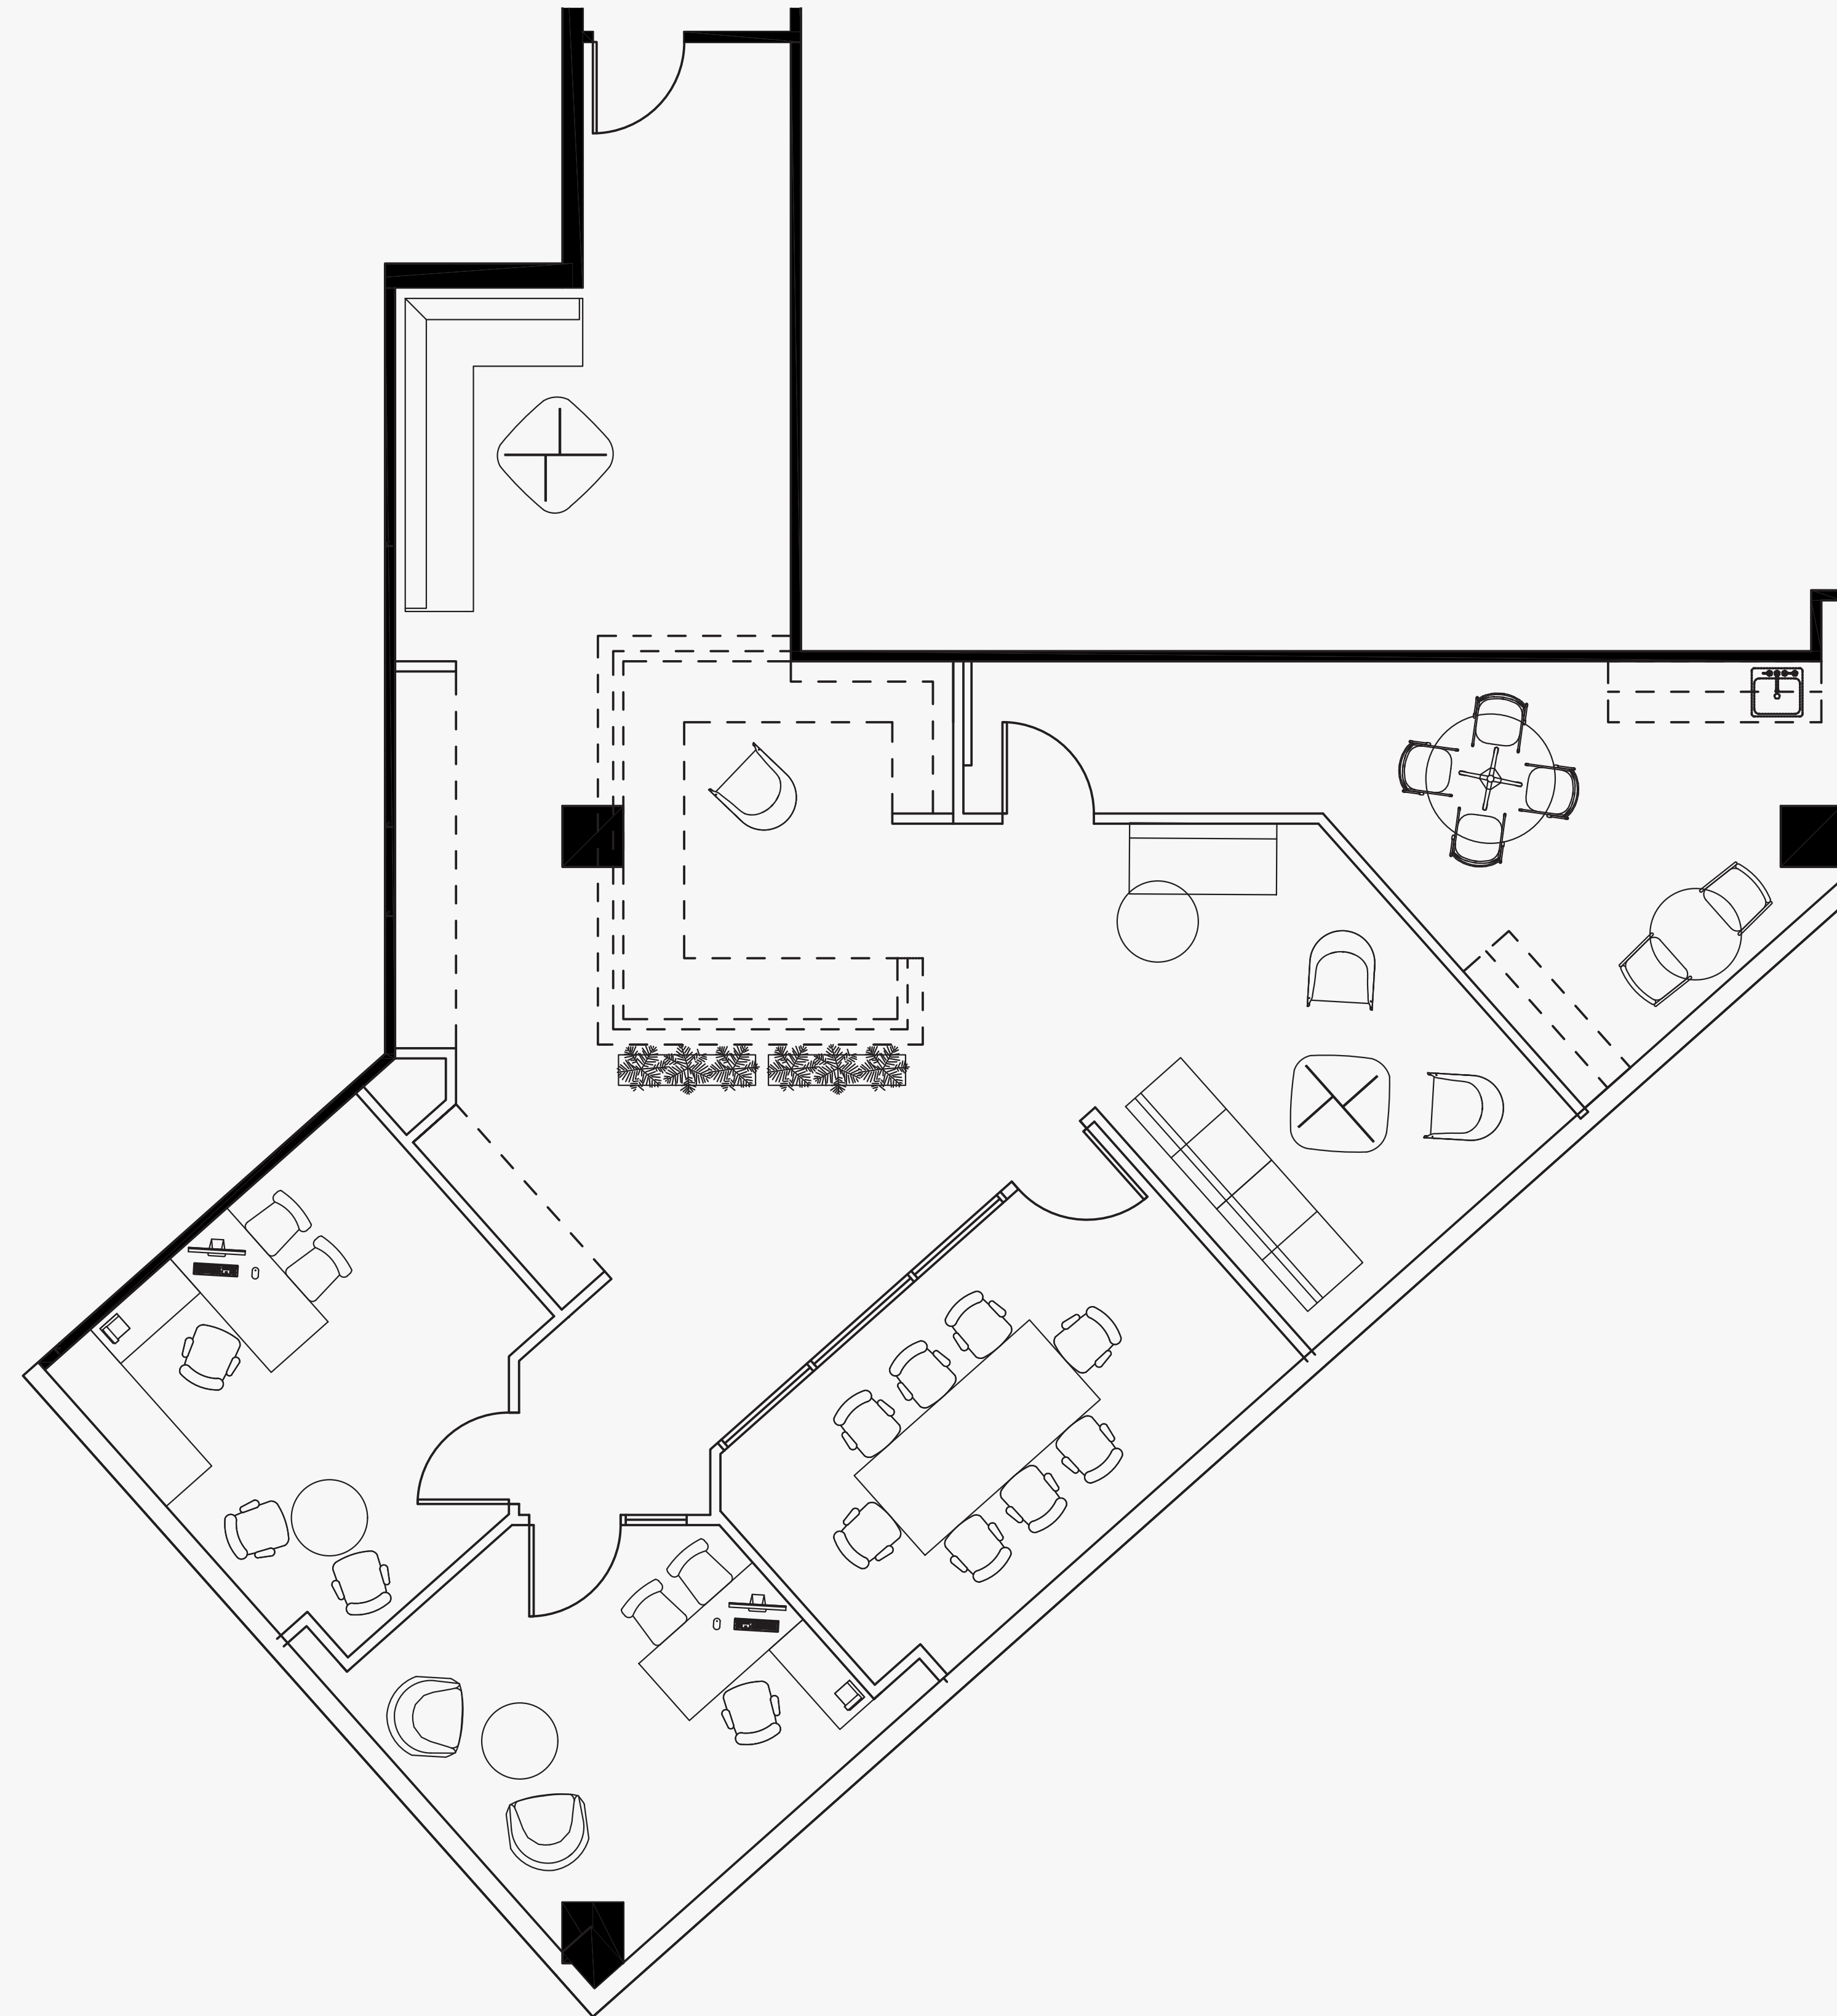

For leasing information please contact:

Tom Sheets | Lic. 01252183
310.363.4943 | 213.440.0269
tom.sheets@cbre.com

Quint Carroll | Lic. 01914692
310.363.4973 | 310.344.2488
quint.carroll@cbre.com