



SUITE: 630

RSF: 1,909

AS-BUILT CONFIGURATION

PRIVATE OFFICES.....	2
RECEPTION.....	1
CONFERENCE ROOMS.....	1
KITCHEN/BREAKOUT	1
OPEN WORK AREA.....	+/- 8

KEY PLAN

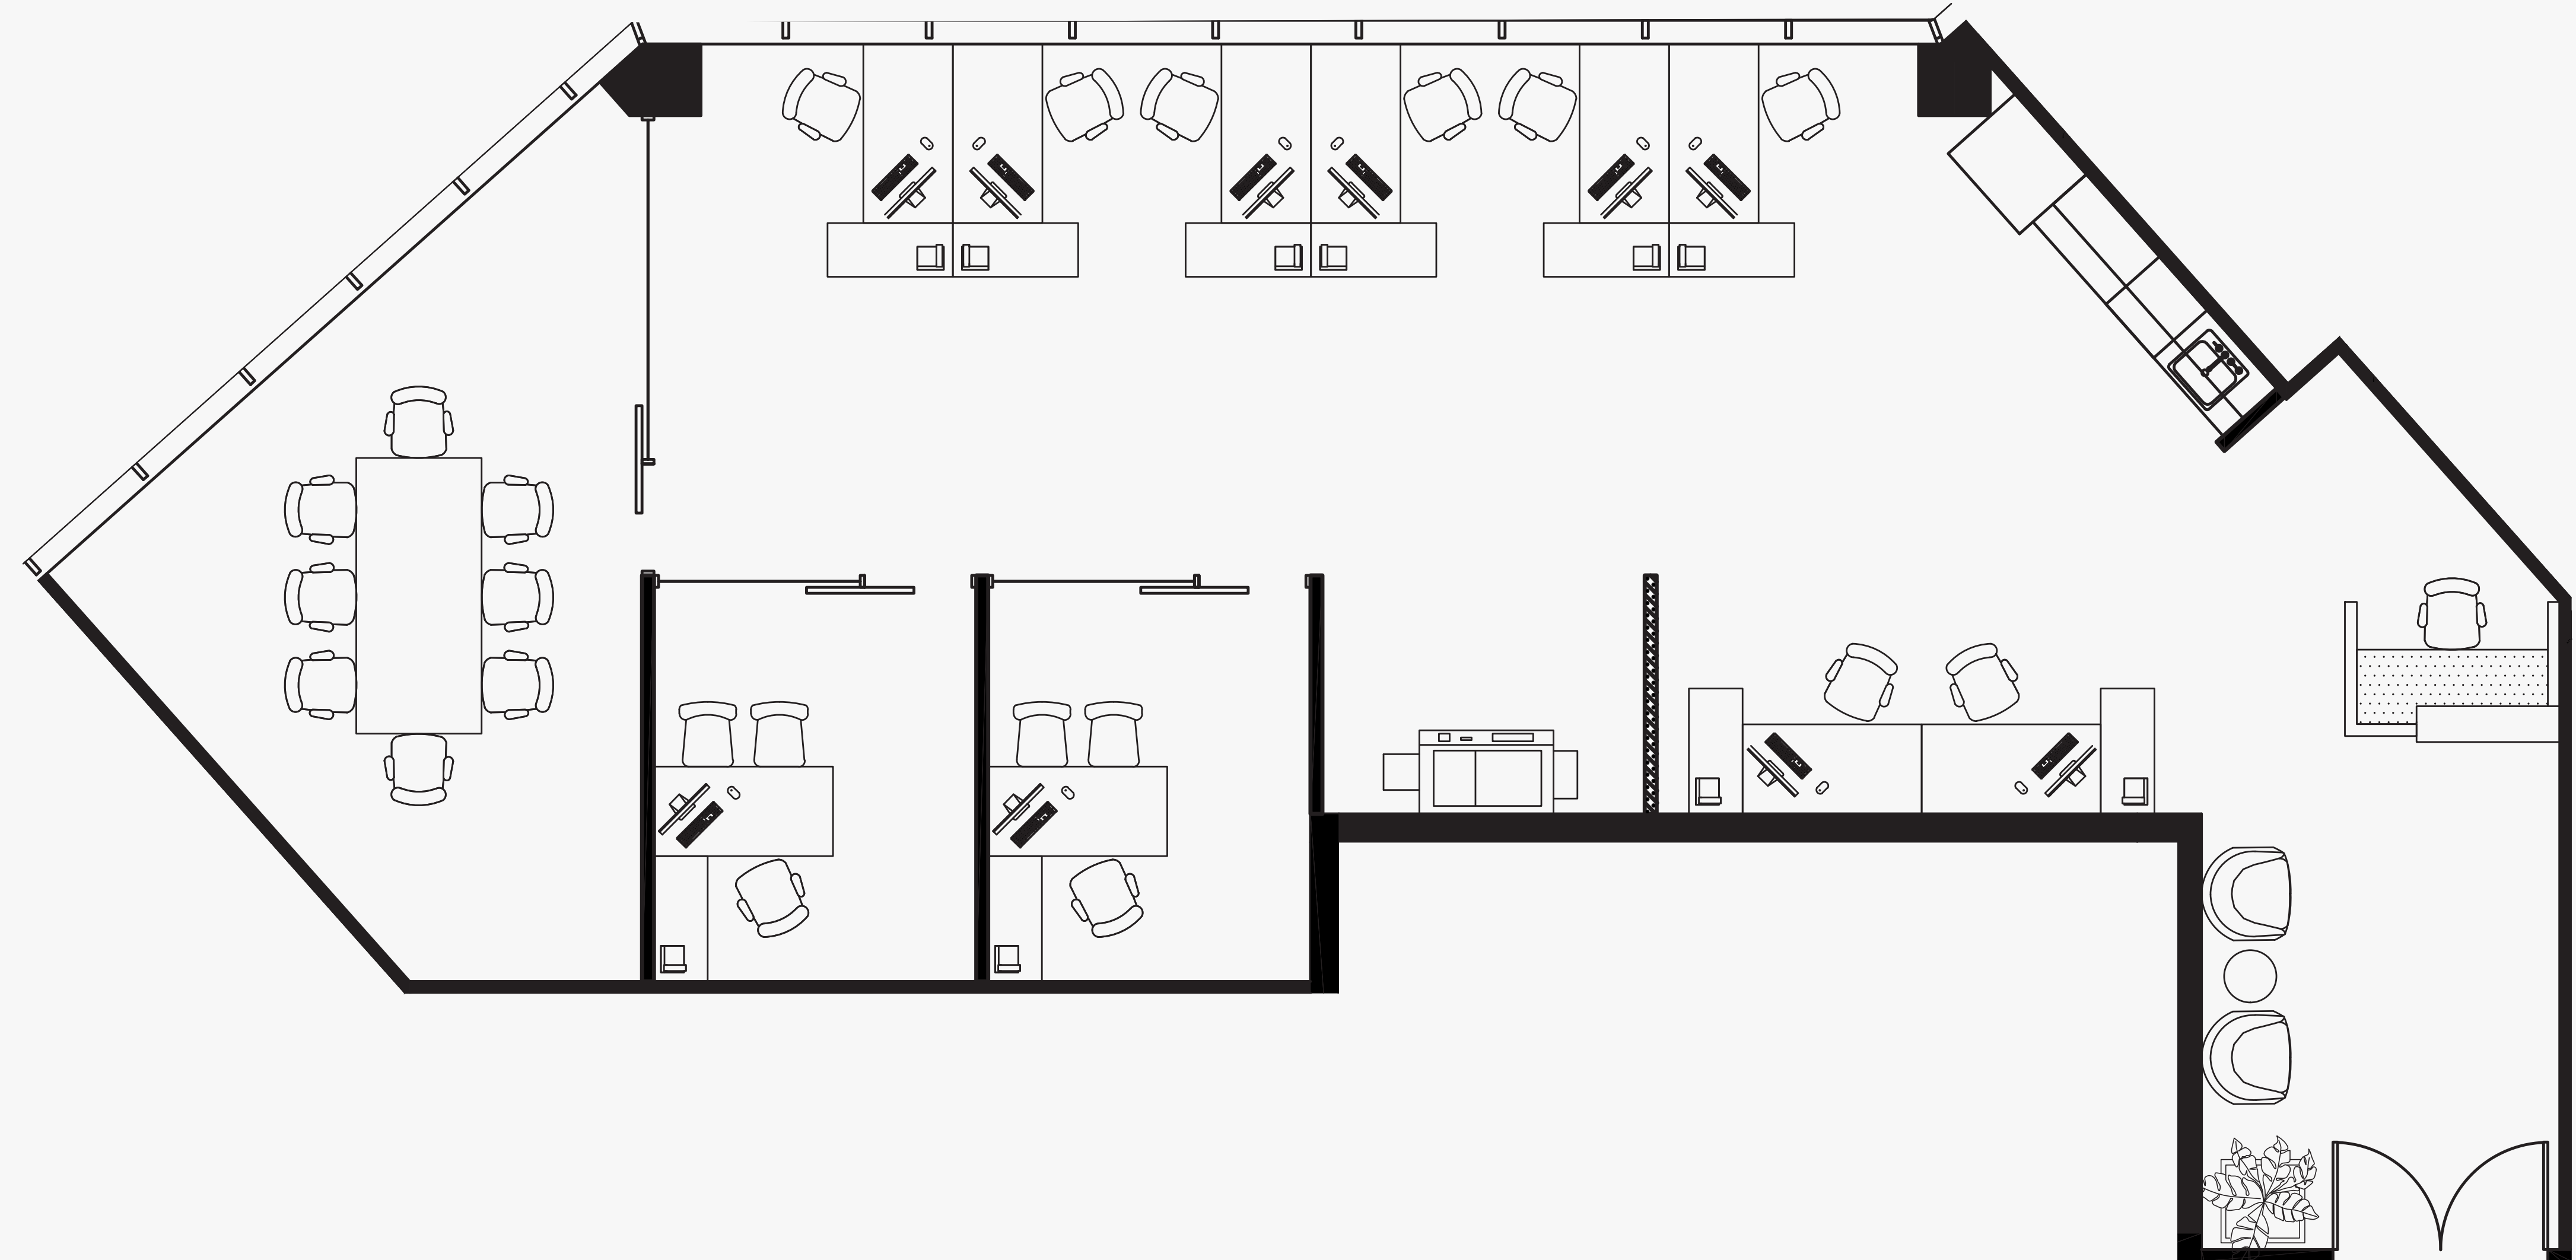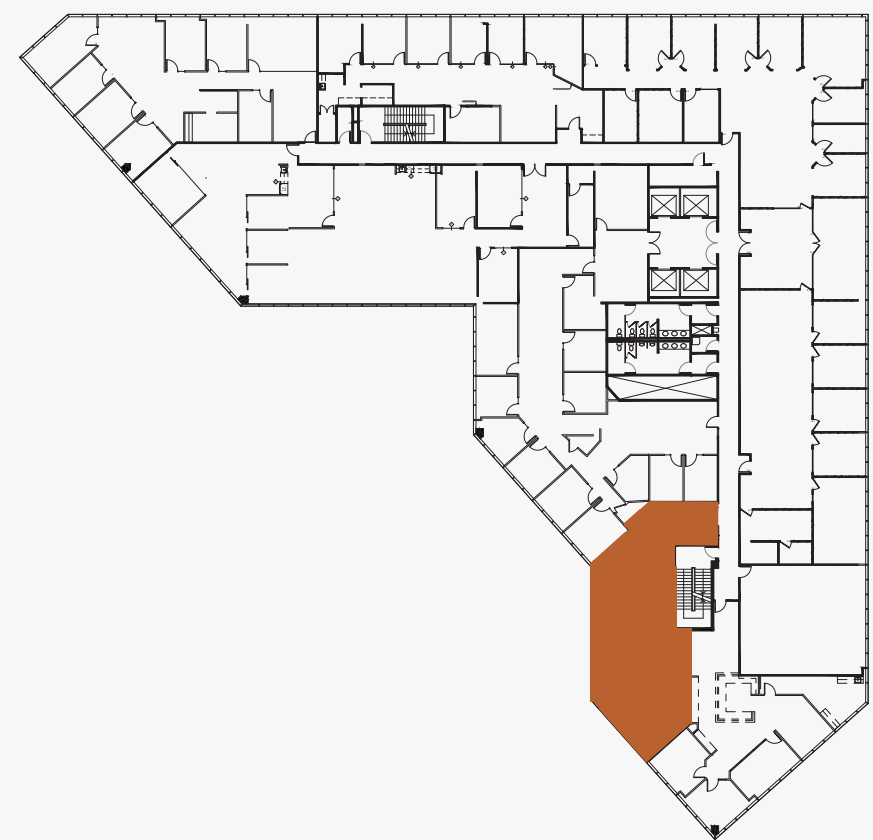

For leasing information please contact:

Tom Sheets | Lic. 01252183 Quint Carroll | Lic. 01914692
310.363.4943 | 213.440.0269 310.363.4973 | 310.344.2488
tom.sheets@cbre.com quint.carroll@cbre.com