
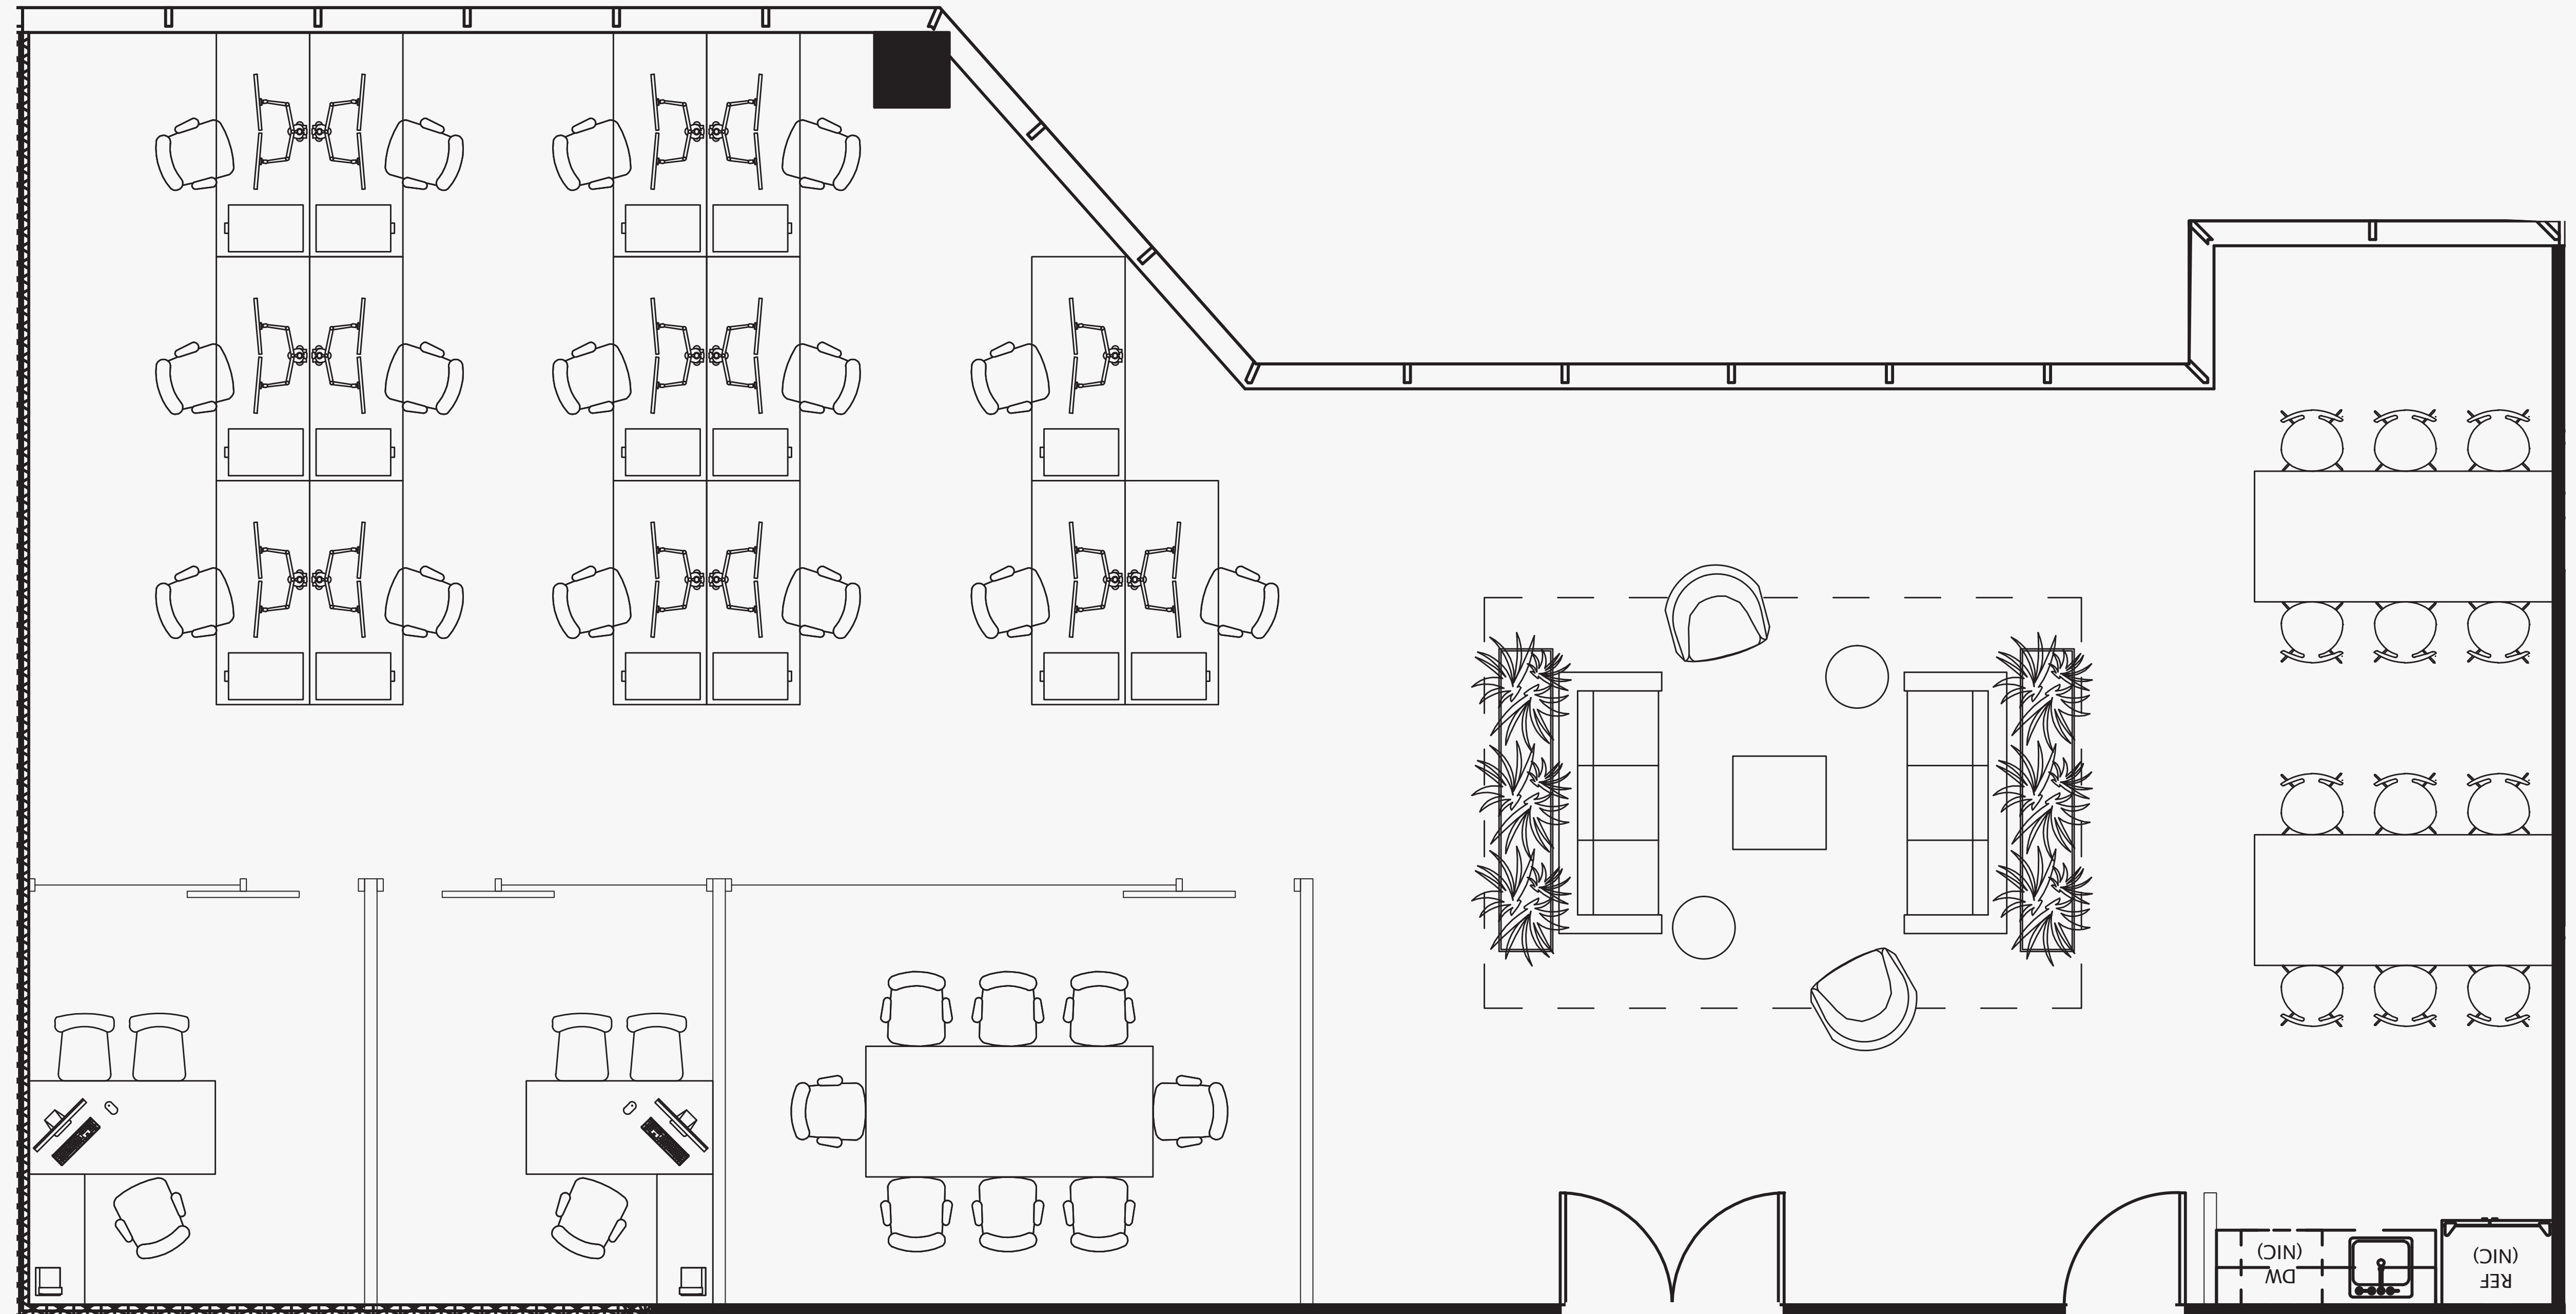


## AS-BUILT CONFIGURATION

- PRIVATE OFFICES..... 2
- CONFERENCE ROOM..... 1
- OPEN WORK AREA ..... +/- 15
- BREAK OUT / LOUNGE..... 3
- PANTRY..... 1

## KEY PLAN

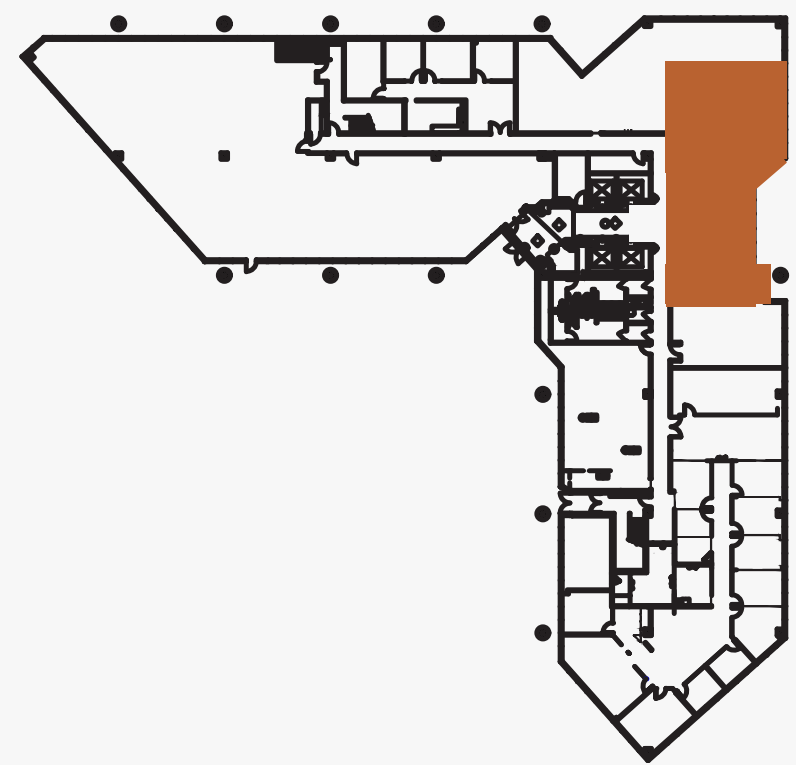

For leasing information please contact:

Tom Sheets | Lic. 01252183    Quint Carroll | Lic. 01914692  
310.363.4943 | 213.440.0269    310.363.4973 | 310.344.2488  
tom.sheets@cbre.com            quint.carroll@cbre.com