





AS-BUILT CONFIGURATION

OFFICES	96
CONFERENCE ROOM	10
OPEN WORK AREA	N/A
BREAK OUT / LOUNGE	1
PANTRY	1

KEY PLAN

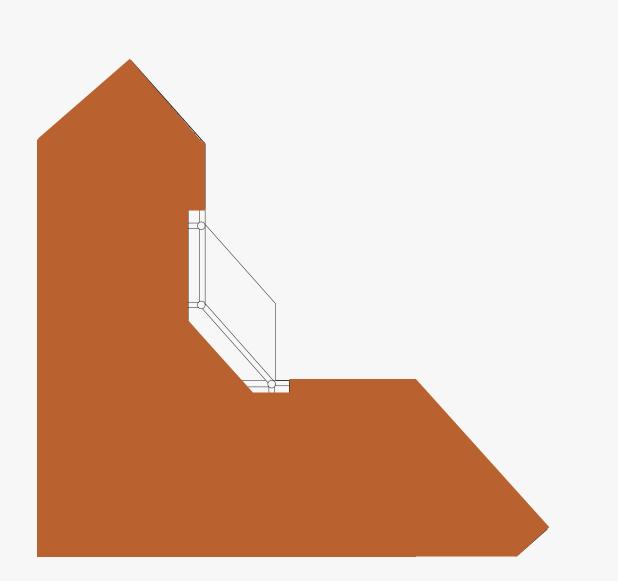

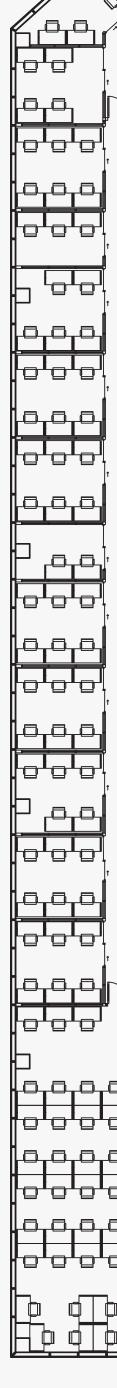

For leasing information please contact: USALEASING@onni.com 213-629-2041

