


## AS-BUILT CONFIGURATION

- RECEPTION.....1
- PRIVATE OFFICES.....6
- CONFERENCE ROOMS.....2
- HUDDLE ROOMS.....1
- KITCHEN.....1
- OPEN WORK AREA.....+/-53

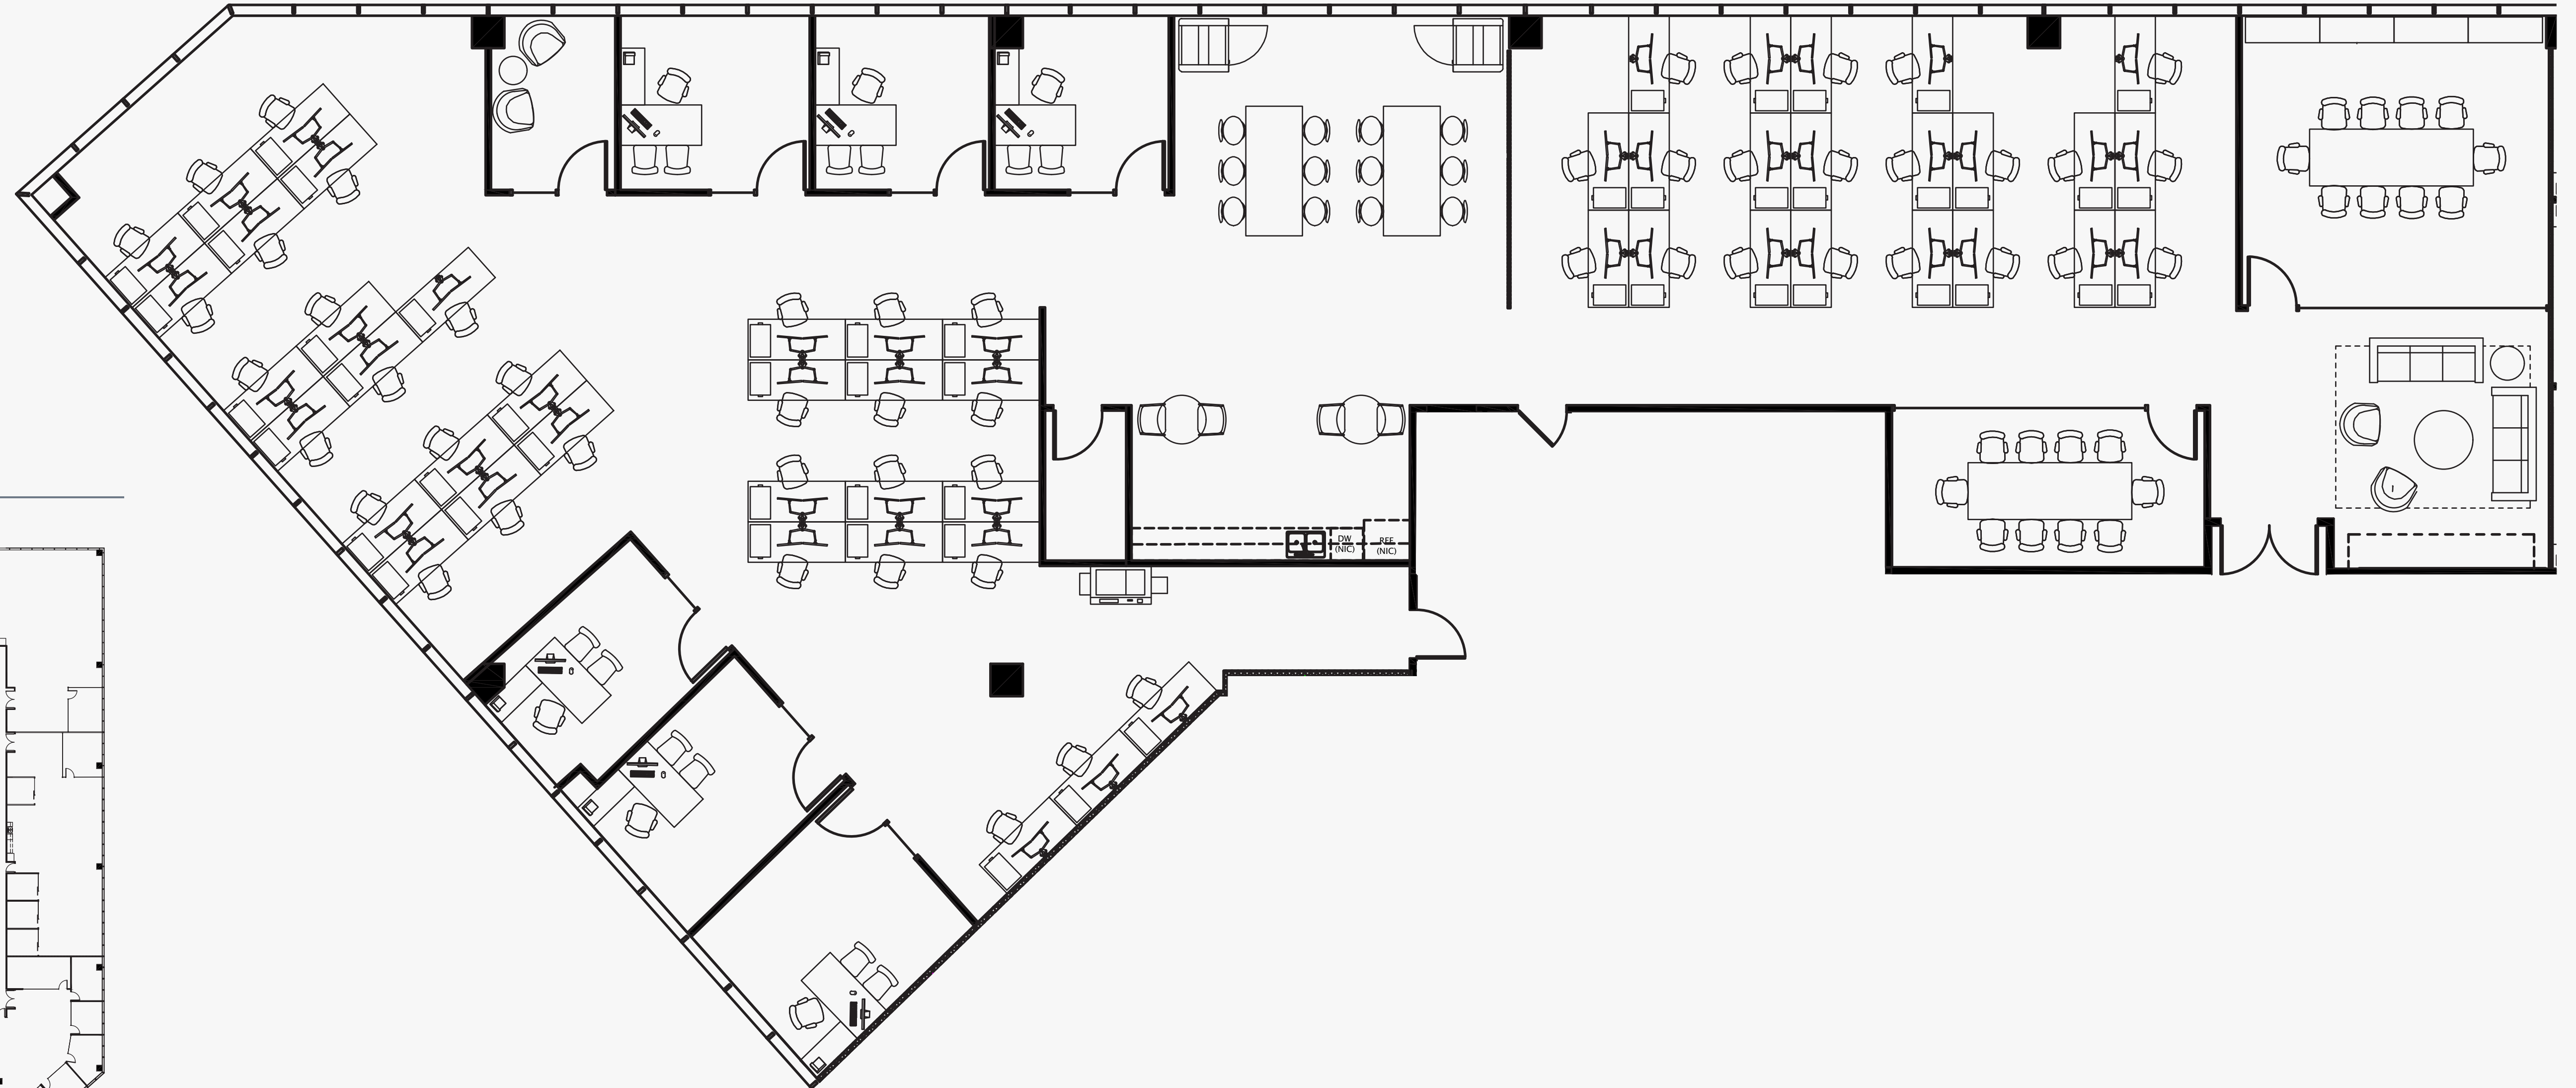

## KEY PLAN

*Not to scale, furniture and appliances not included*

