




AS-BUILT CONFIGURATION

OFFICES	9
CONFERENCE ROOM	1
OPEN WORK AREA	+/- 77
BREAK OUT / LOUNGE	N/A
PANTRY	N/A

KEY PLAN

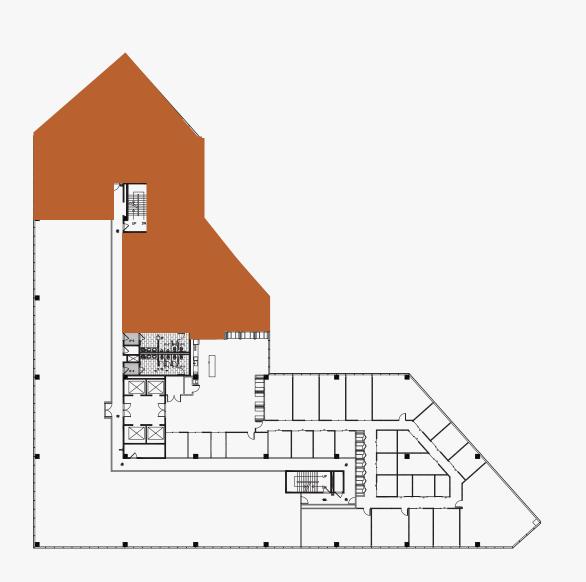

For leasing information please contact: USALEASING@onni.com 213-629-2041

