
SUITE: 100


RSF: 14,203

AS-BUILT CONFIGURATION

OFFICES	37
CONFERENCE ROOM	3
OPEN WORK AREA	N/A
BREAK OUT / LOUNGE	1
PANTRY	1

KEY PLAN

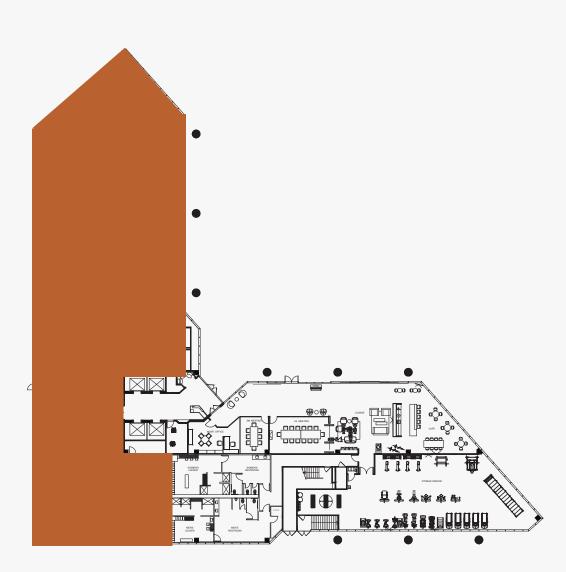

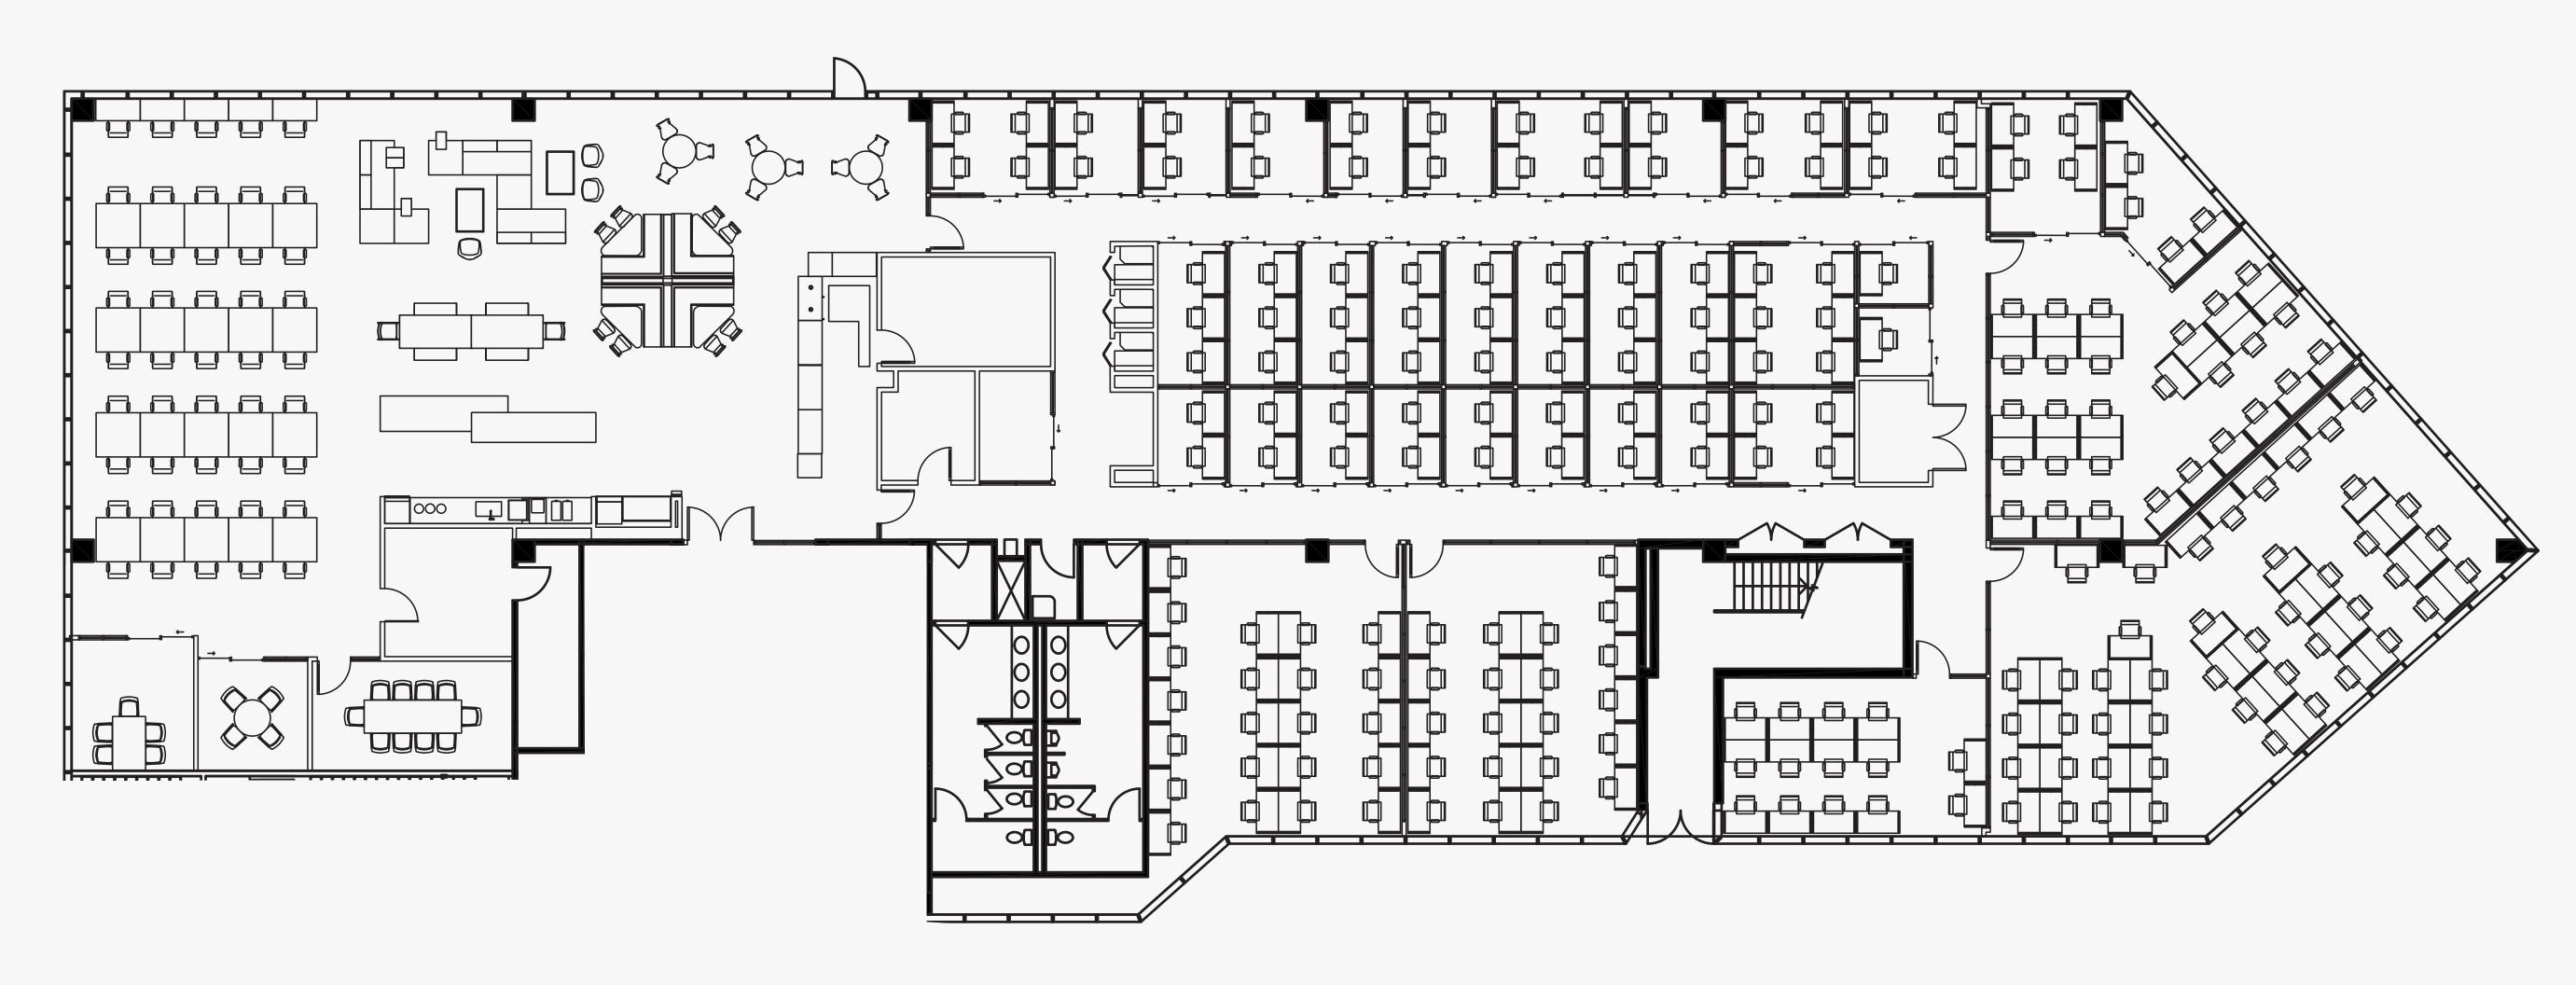

For leasing information please contact: USALEASING@onni.com 213-629-2041



