

SUITE: 400



RSF: 5,568

MBT
MANHATTAN BEACH TOWERS

AS-BUILT CONFIGURATION

OFFICES.....	14
RECEPTION.....	1
CONFERENCE ROOMS.....	2
KITCHEN/BREAKOUT	1
OPEN WORK AREA.....	+/-8

KEY PLAN

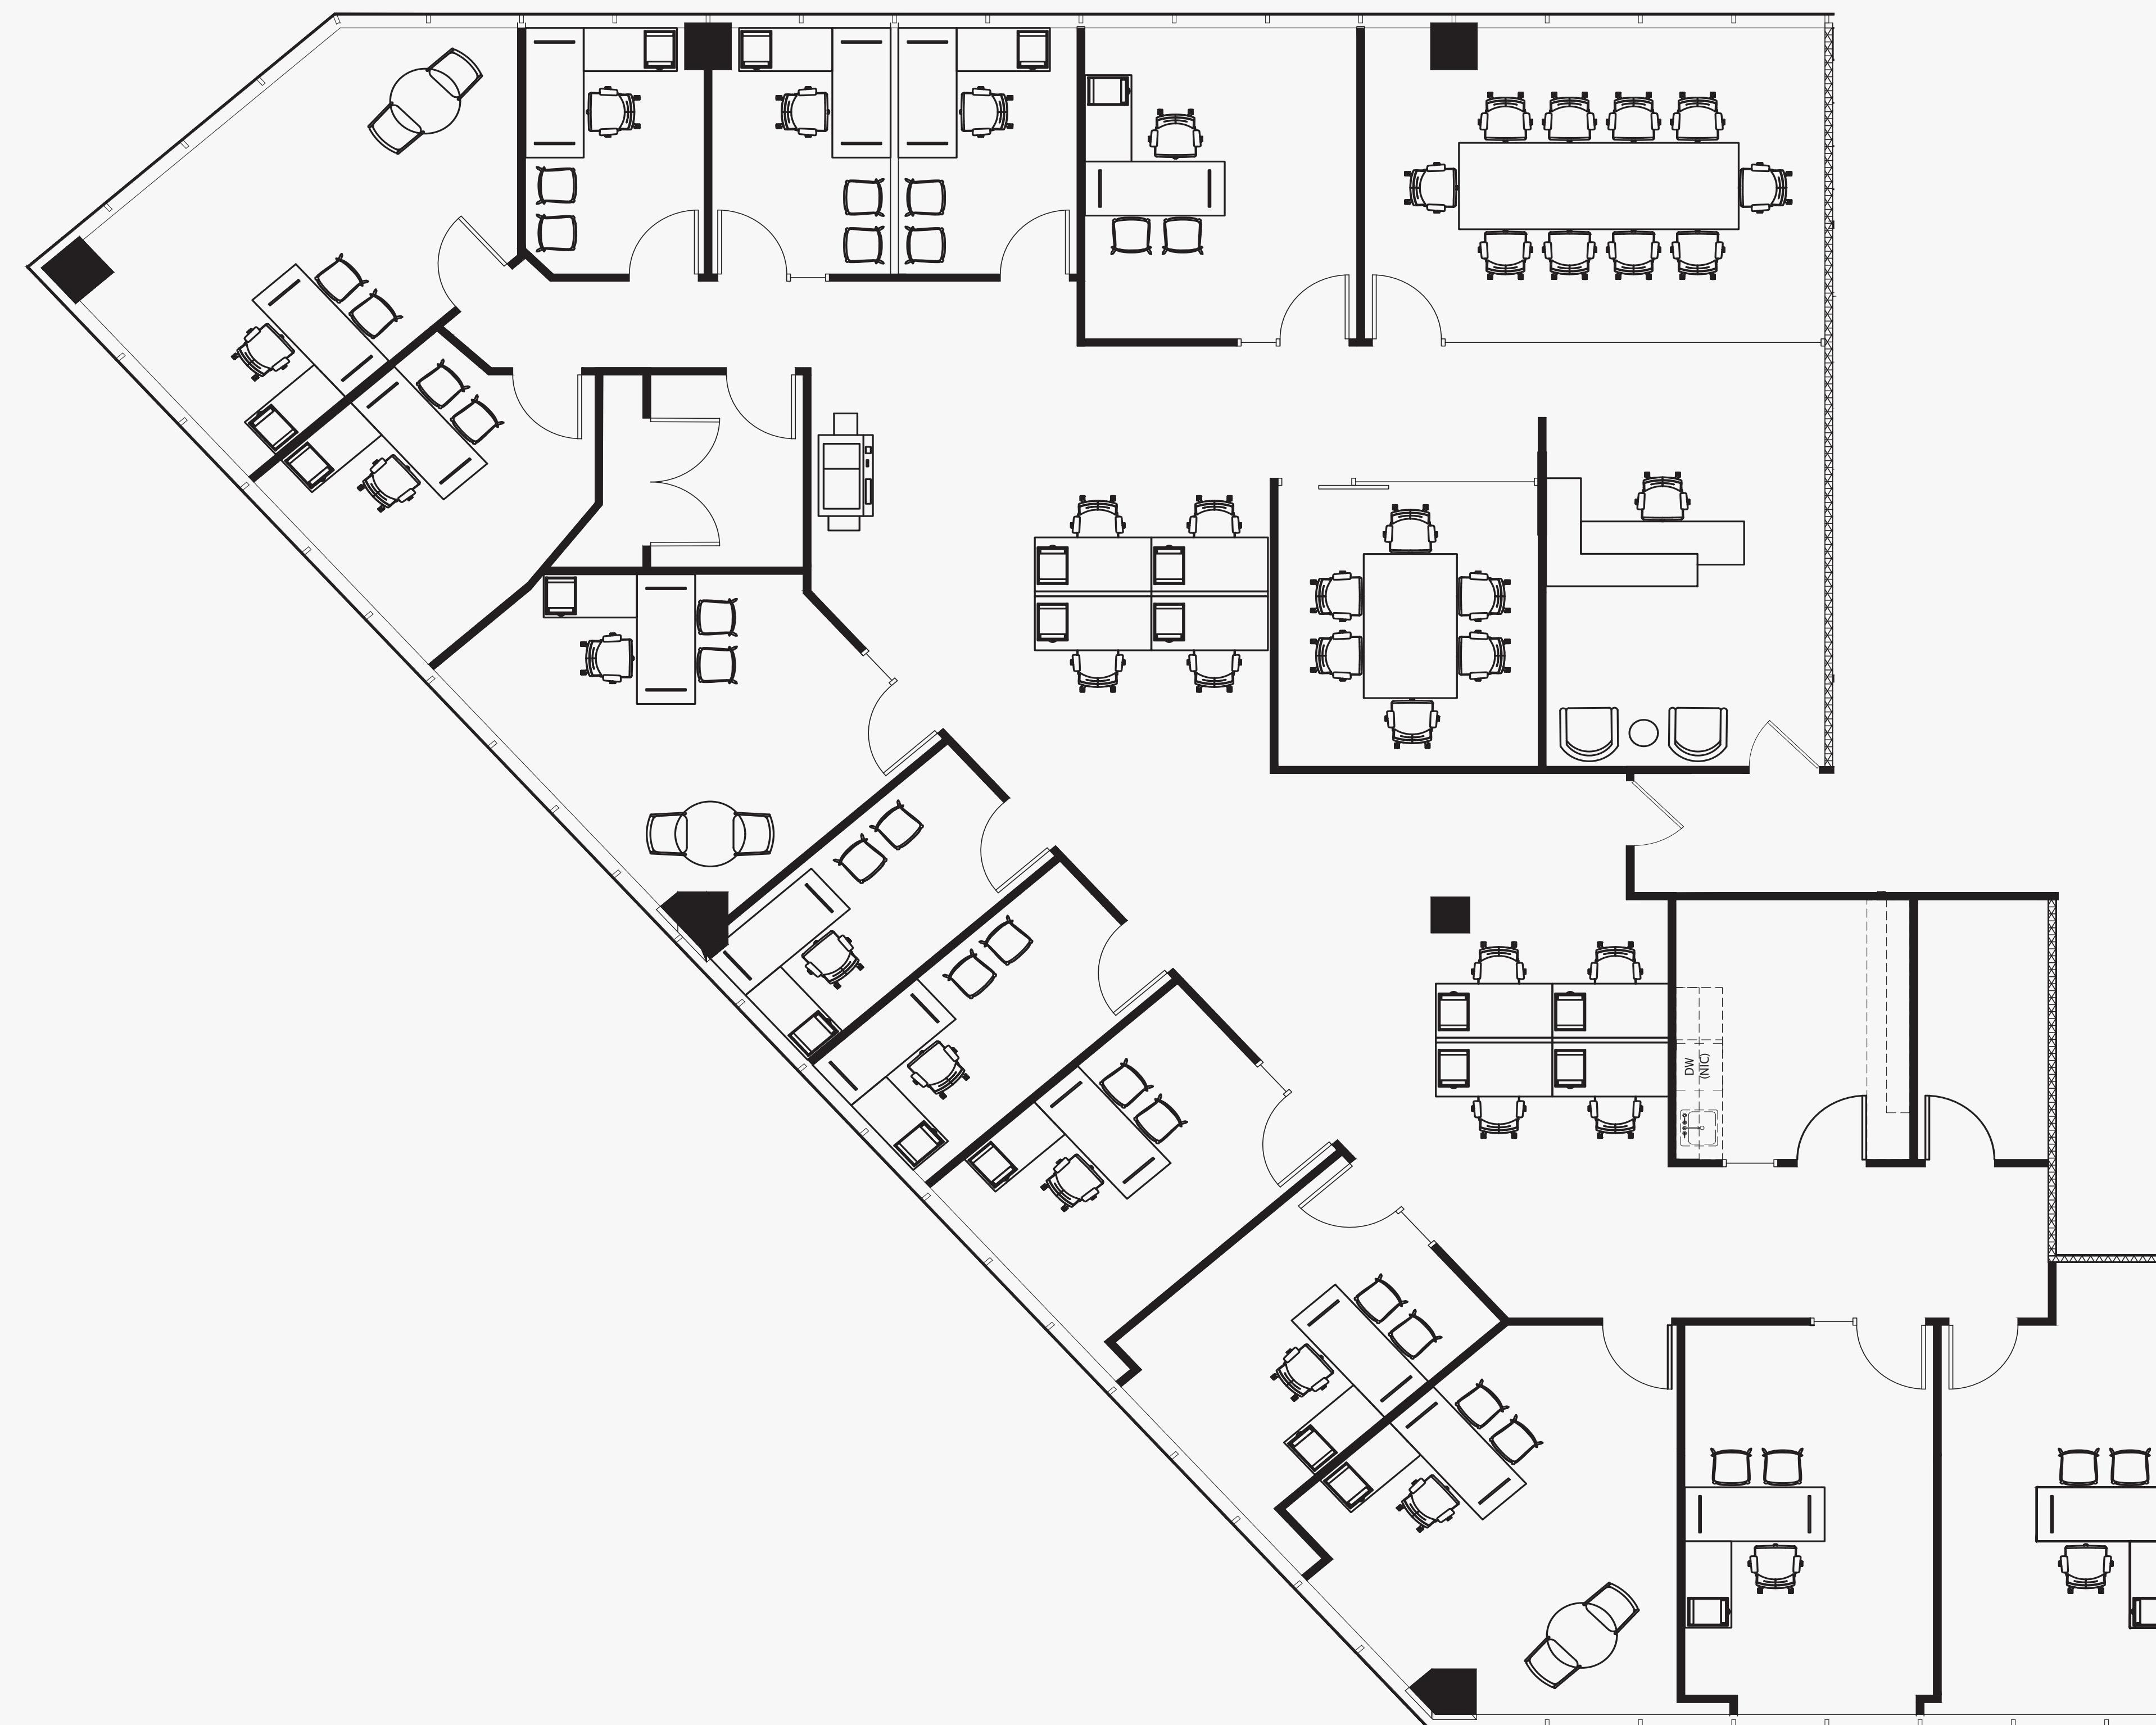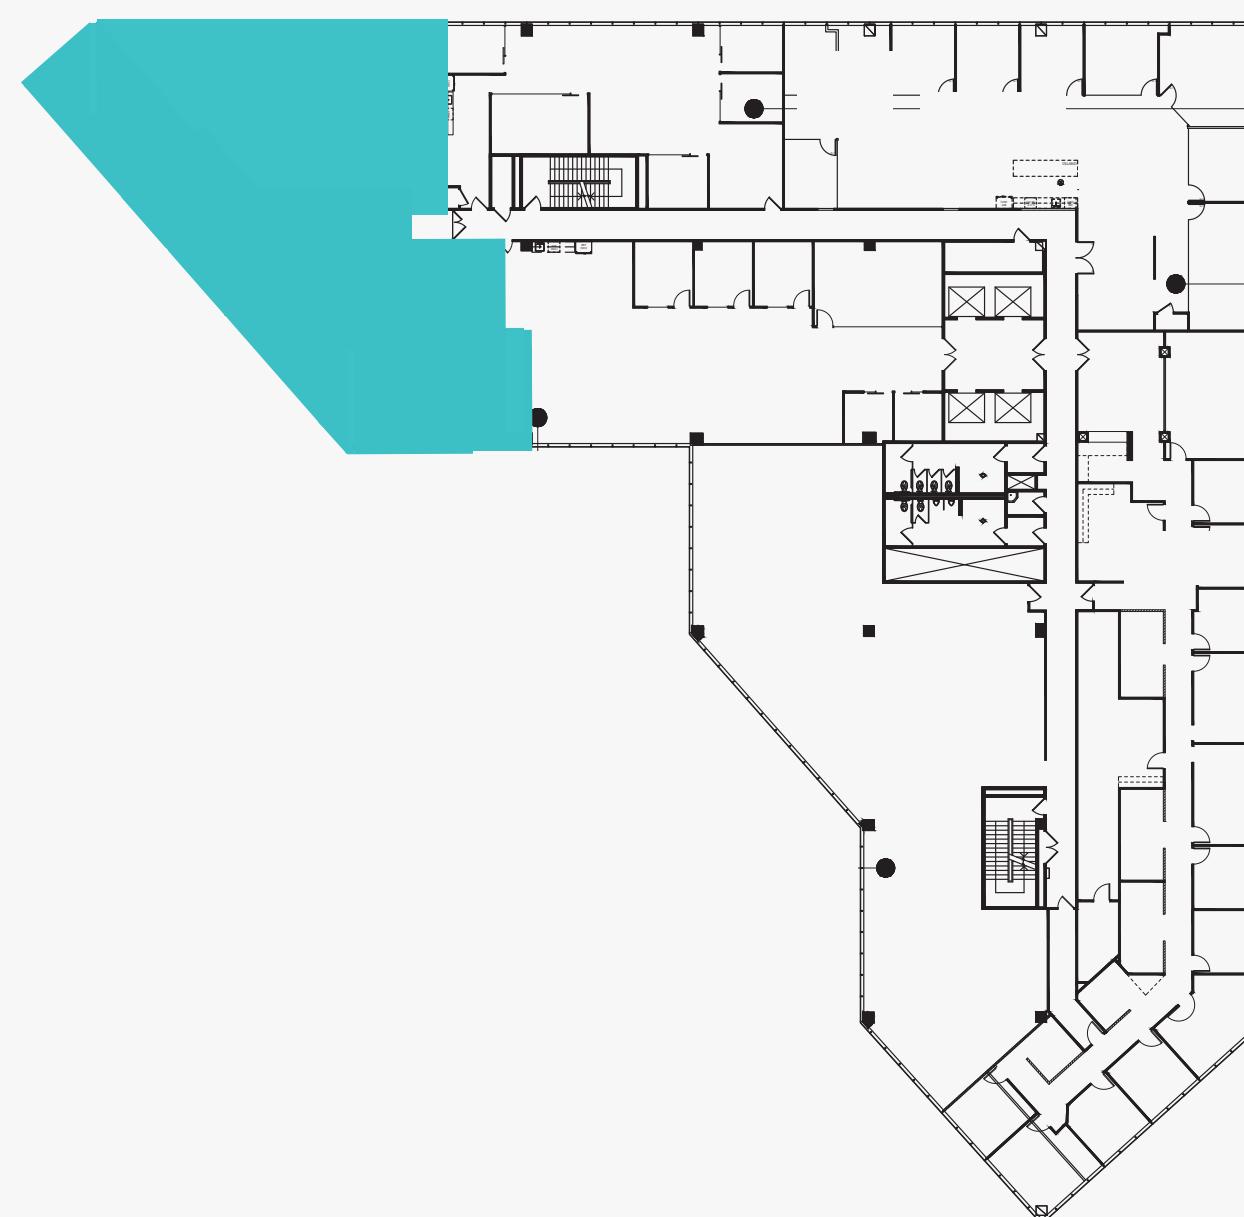

onni
group