SUITE: 115 RSF: 2,458

MANHATTAN BEACH TOWERS

AS-BUILT CONFIGURATION

PRIVATE OFFICES..... 2

CONFERENCE ROOM..... 1

OPEN WORK AREA .....+/- 15

BREAK OUT / LOUNGE.....3

PANTRY..... 1

KEY PLAN

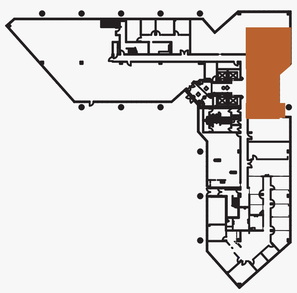

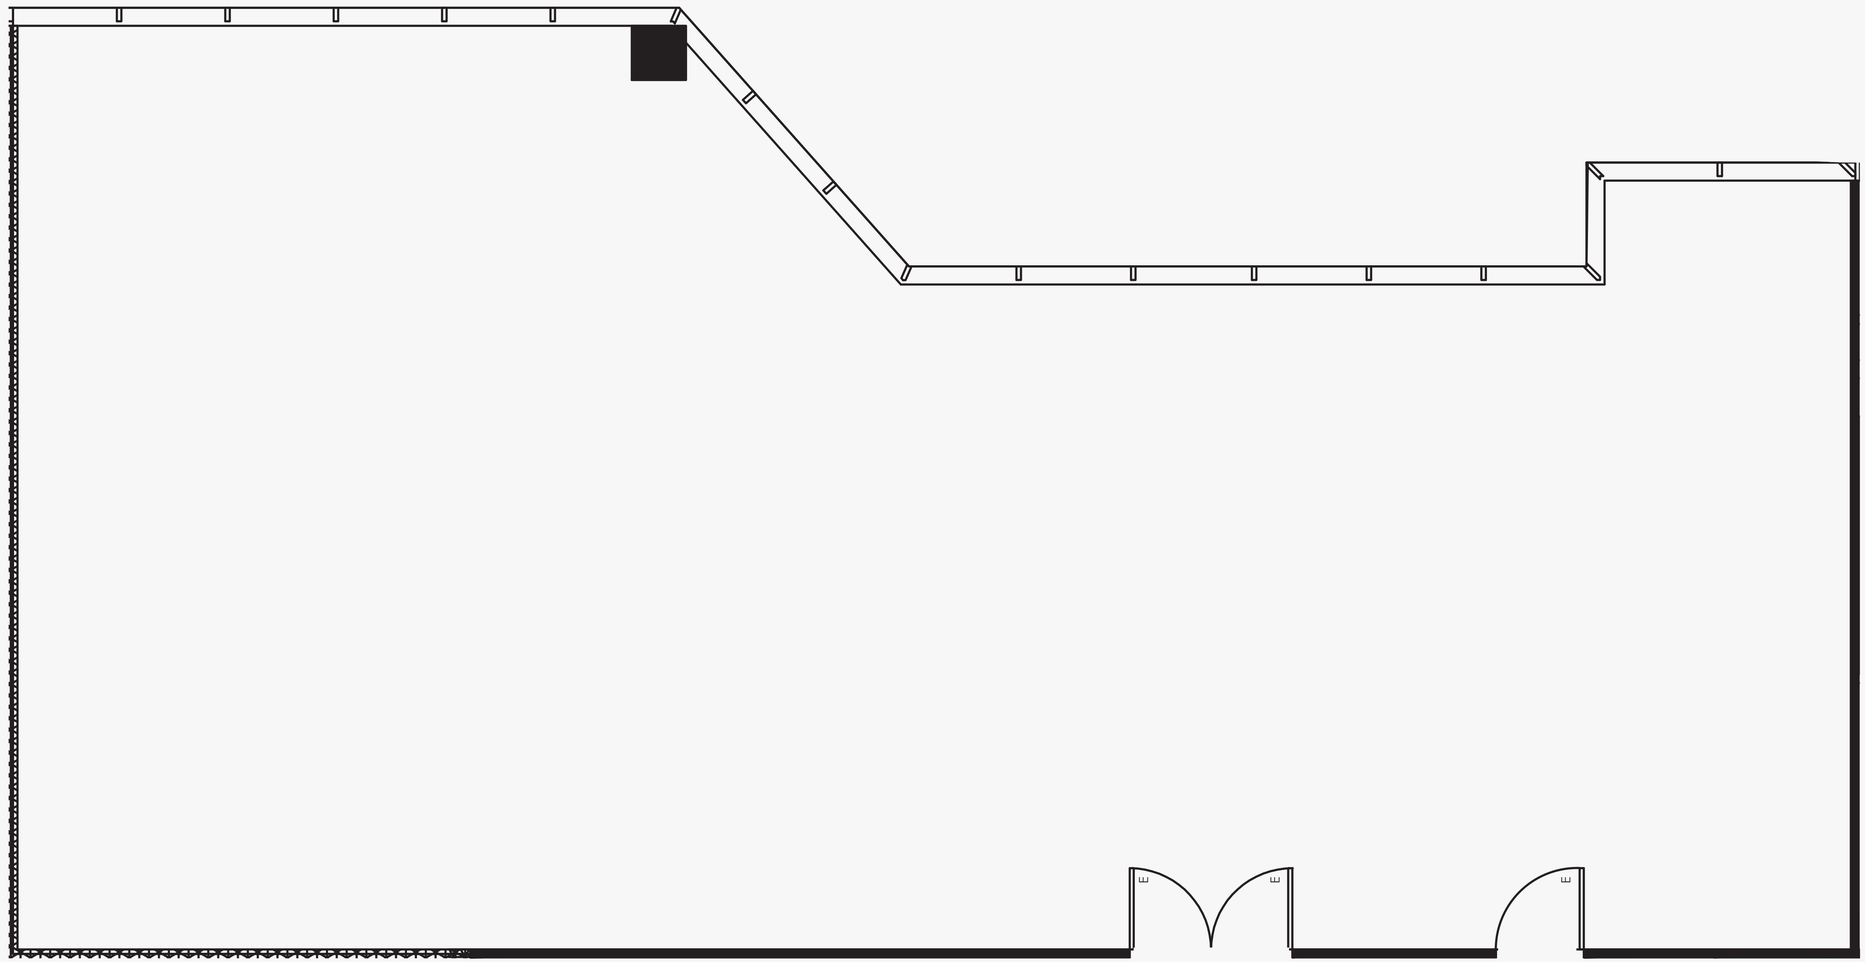

For leasing information please contact:
USALEASING@ONNI.COM
(213) 629-2041