SUITE: 210 RSF: 1,565

MANHATTAN BEACH TOWERS

AS-BUILT CONFIGURATION

OFFICES..... 1

RECEPTION..... 1

CONFERENCE ROOMS..... 1

KITCHEN/BREAKOUT 1

OPEN WORK AREA..... +/-8

KEY PLAN

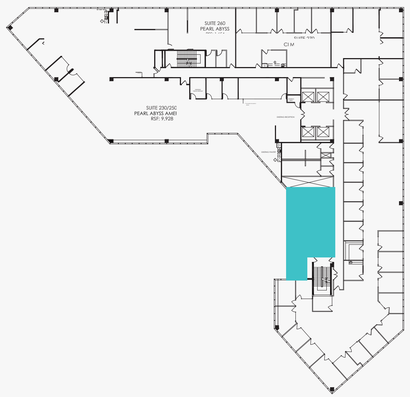

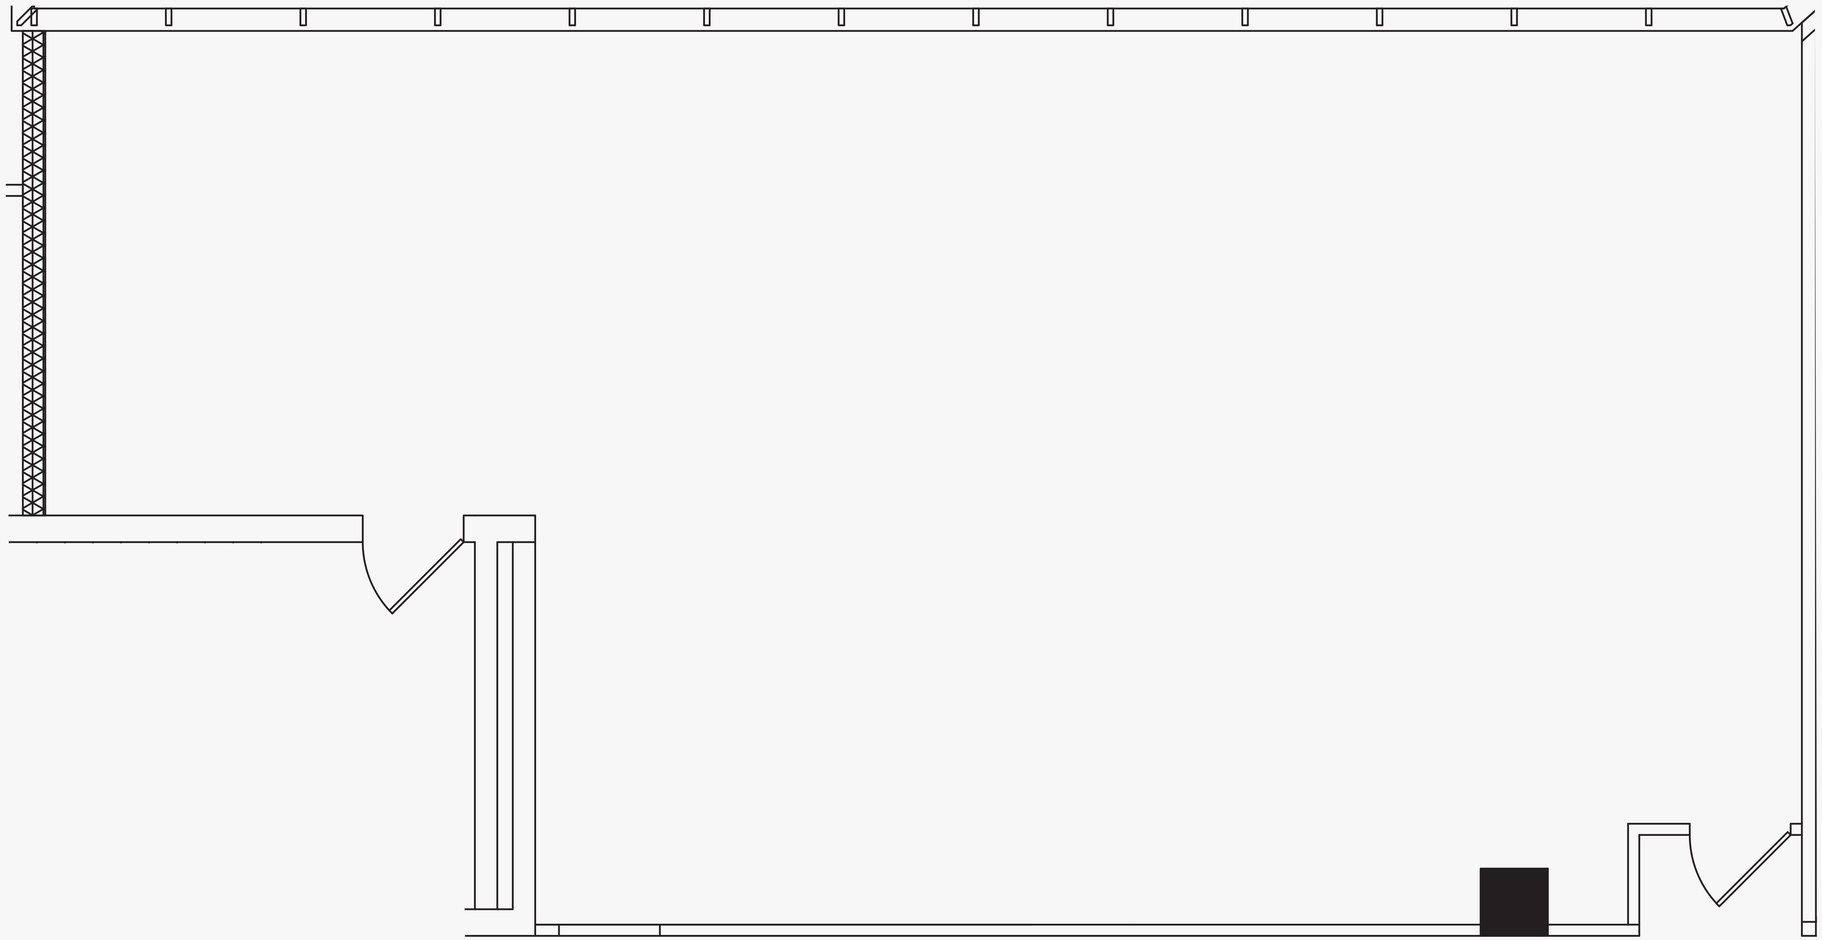

For leasing information please contact:
USALEASING@ONNI.COM
(213) 629-2041