SUITE: 520 RSF: 5,062

MANHATTAN BEACH TOWERS

AS-BUILT CONFIGURATION

OFFICES..... 11

RECEPTION..... 1

CONFERENCE ROOMS..... 2

KITCHEN/BREAKOUT 1

OPEN WORK AREA..... +/- 9

KEY PLAN

FURNITURE AND APPLIANCES NOT INCLUDED

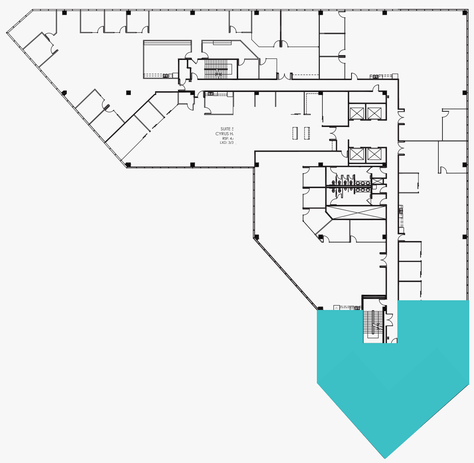

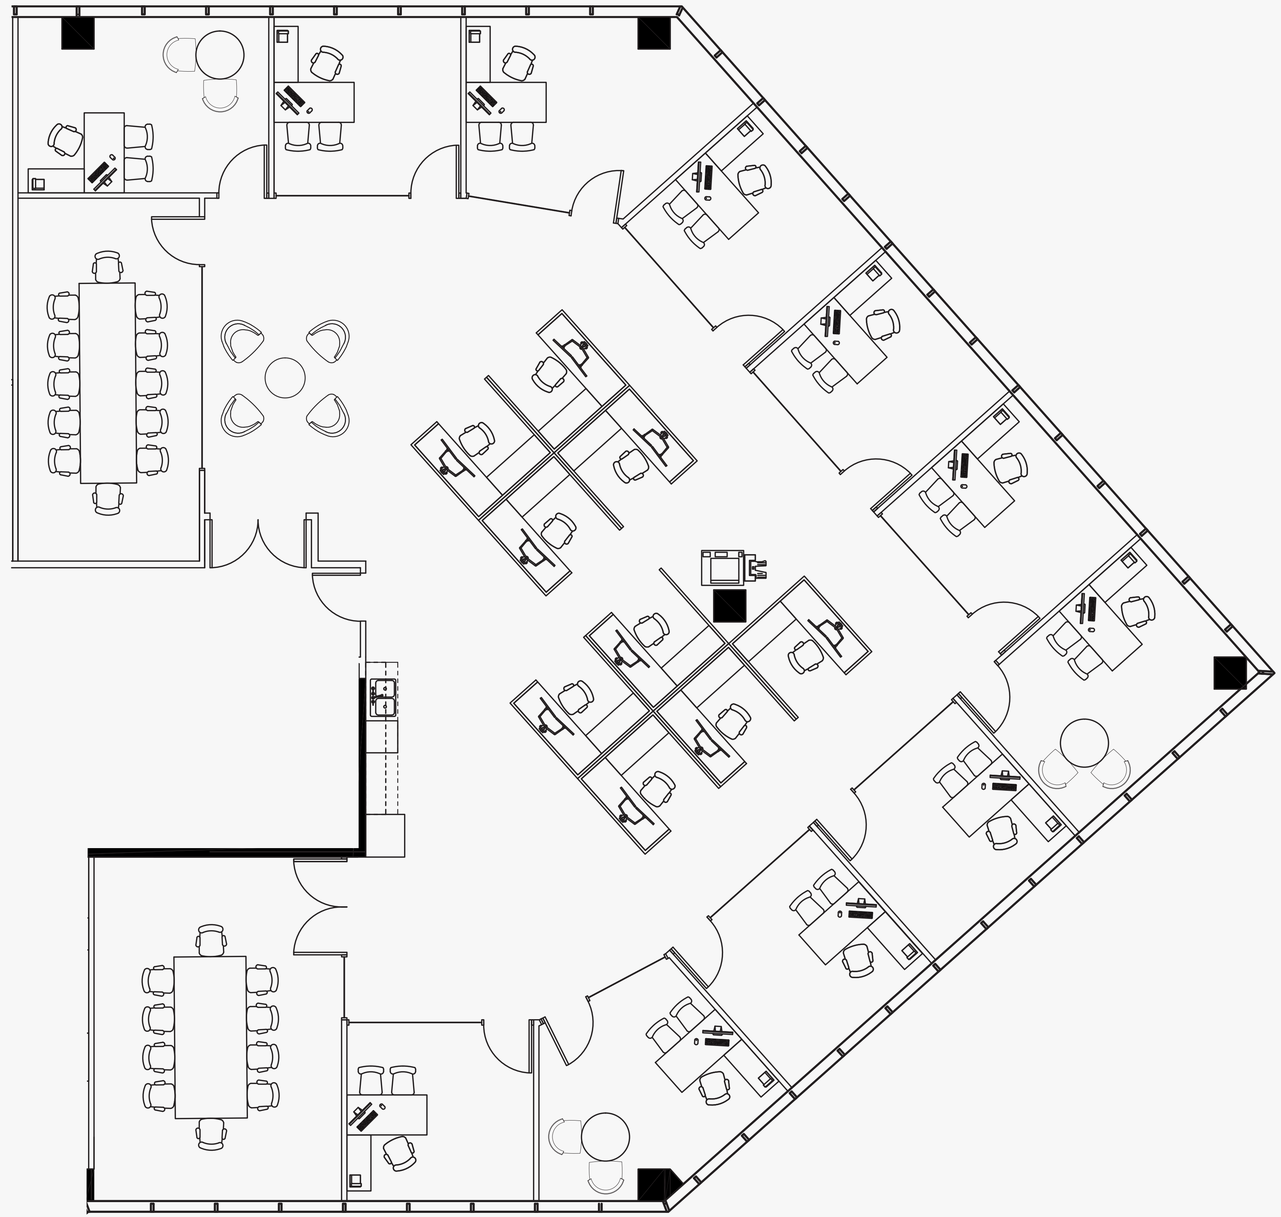

For leasing information please contact:
USALEASING@ONNI.COM
(213) 629-2041

onni group