SUITE: 610 RSF: 1,305

MANHATTAN BEACH TOWERS

AS-BUILT CONFIGURATION

PRIVATE OFFICES.....3

CONFERENCE ROOMS.....1

OPEN WORK AREA.....+/-2

KEY PLAN

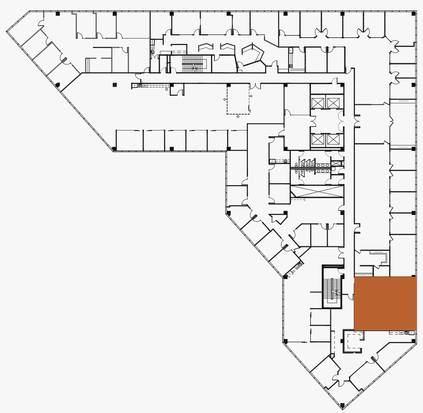

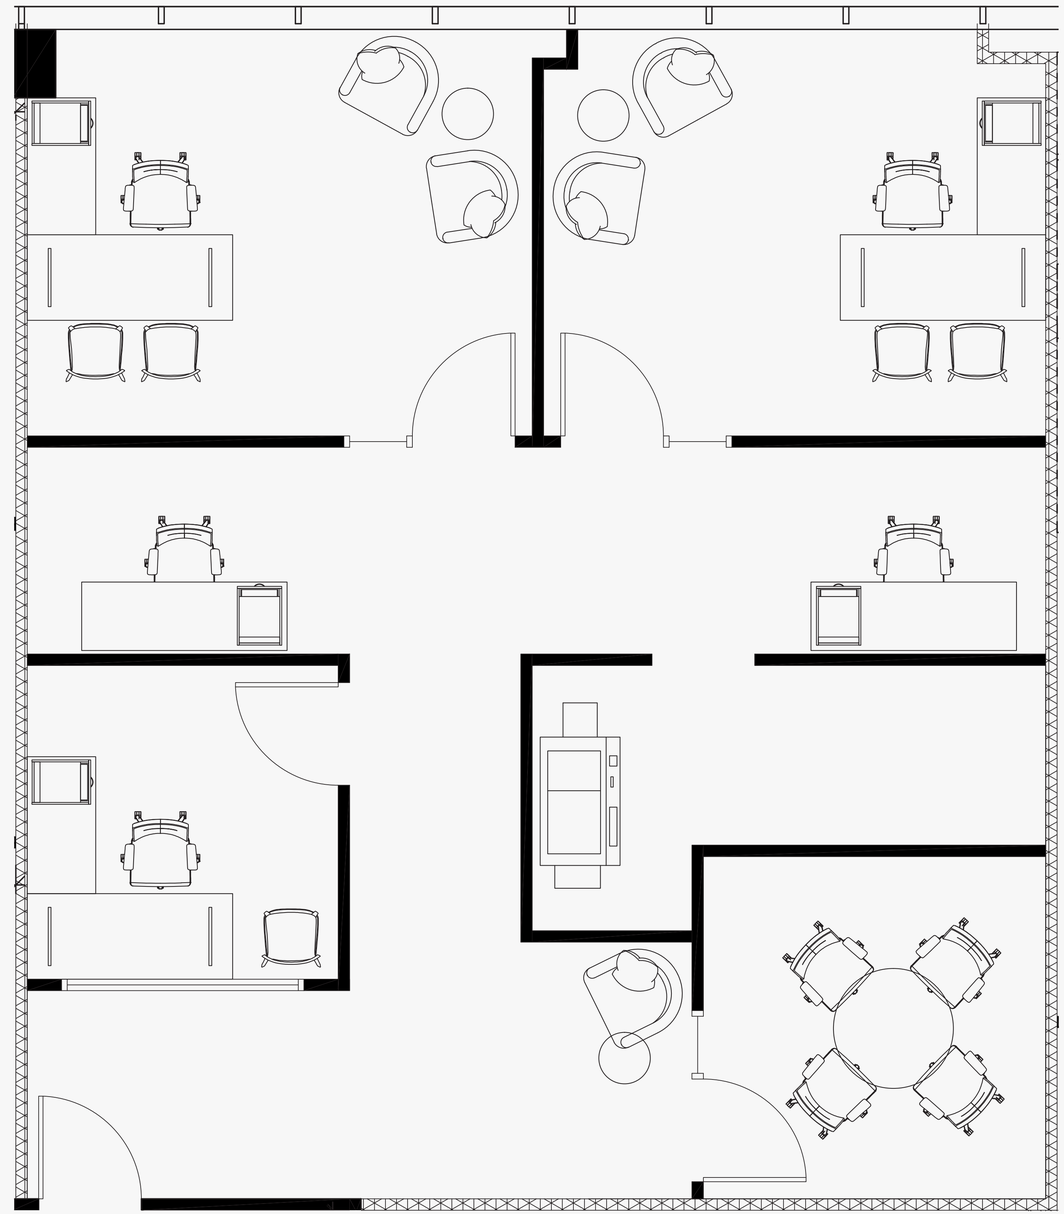

For leasing information please contact:
USALEASING@ONNI.COM
(213) 629-2041

onni group