SUITE: 630 RSF: 1,909

MANHATTAN BEACH TOWERS

AS-BUILT CONFIGURATION

PRIVATE OFFICES	2
RECEPTION	1
CONFERENCE ROOMS	1
KITCHEN/BREAKOUT	1
OPEN WORK AREA	+/-14
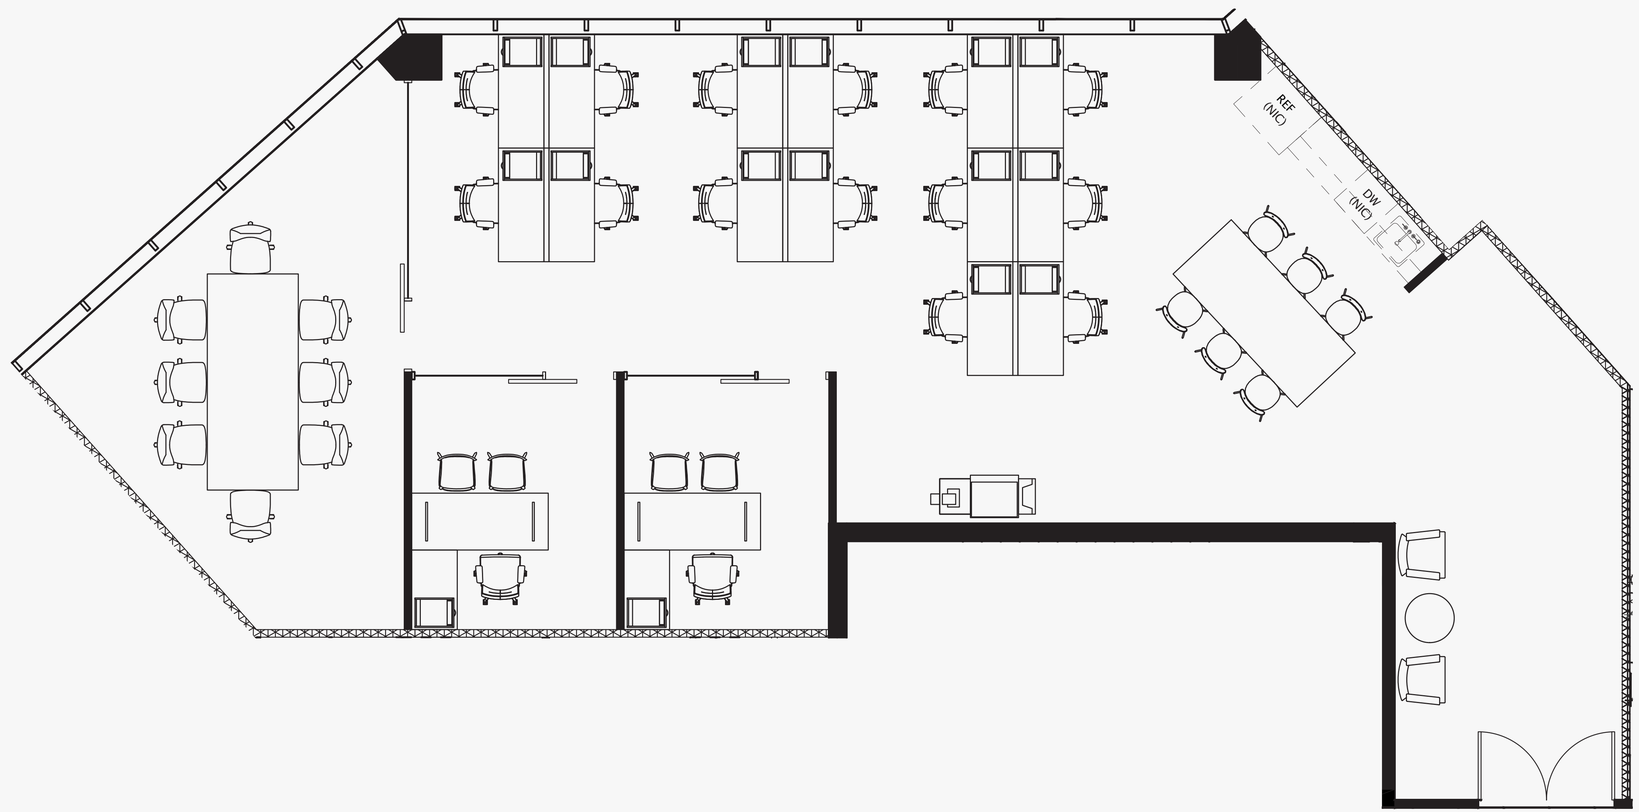
KEY PLAN