SUITE: **220**


RSF: **4,924**


MANHATTAN BEACH TOWERS

AS-BUILT CONFIGURATION

OFFICES	4
CONFERENCE ROOM	2
OPEN WORK AREA	+/- 40
BREAK OUT / LOUNGE	1
PANTRY	1

KEY PLAN

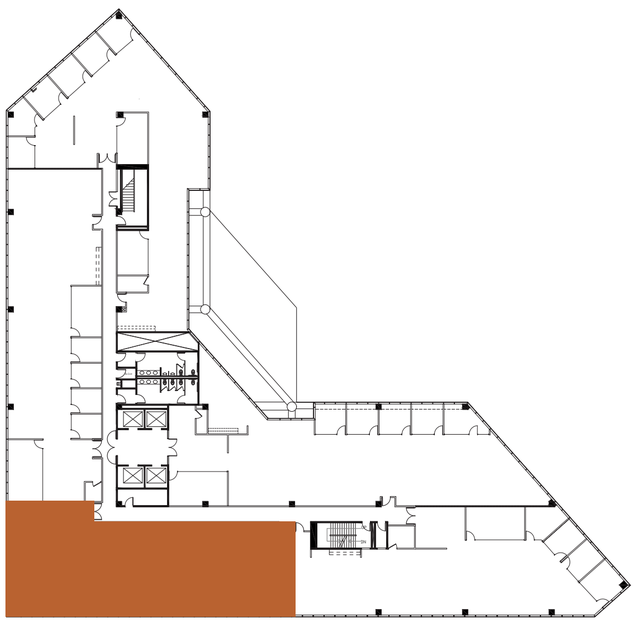

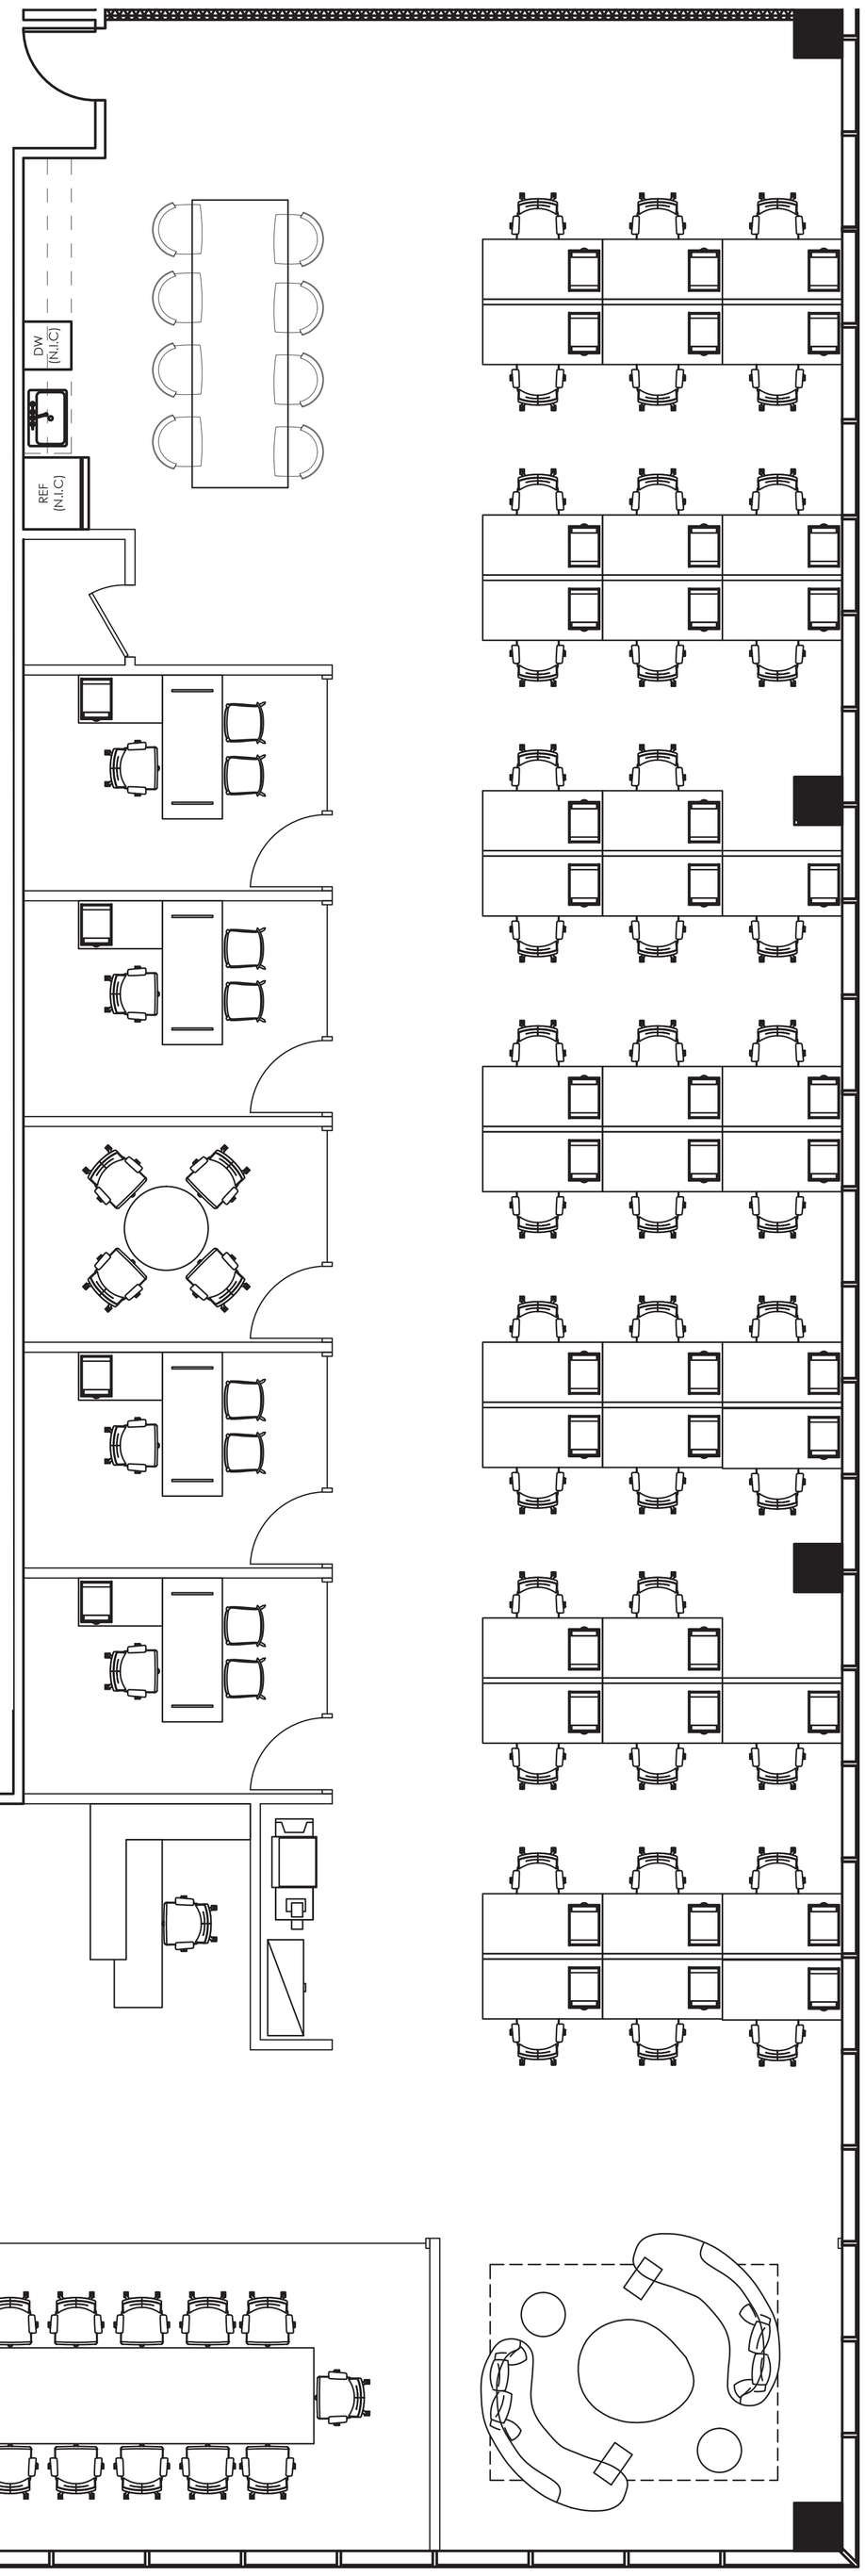

onni group