SUITE: **230** RSF: **5,413**

MBT
MANHATTAN BEACH TOWERS

AS-BUILT CONFIGURATION

OFFICES..... 4


CONFERENCE ROOM..... 2


OPEN WORK AREA ..... +/- 14

BREAK OUT / LOUNGE..... 1

PANTRY..... 1

KEY PLAN

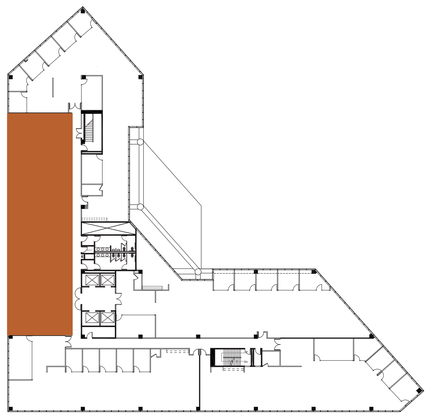

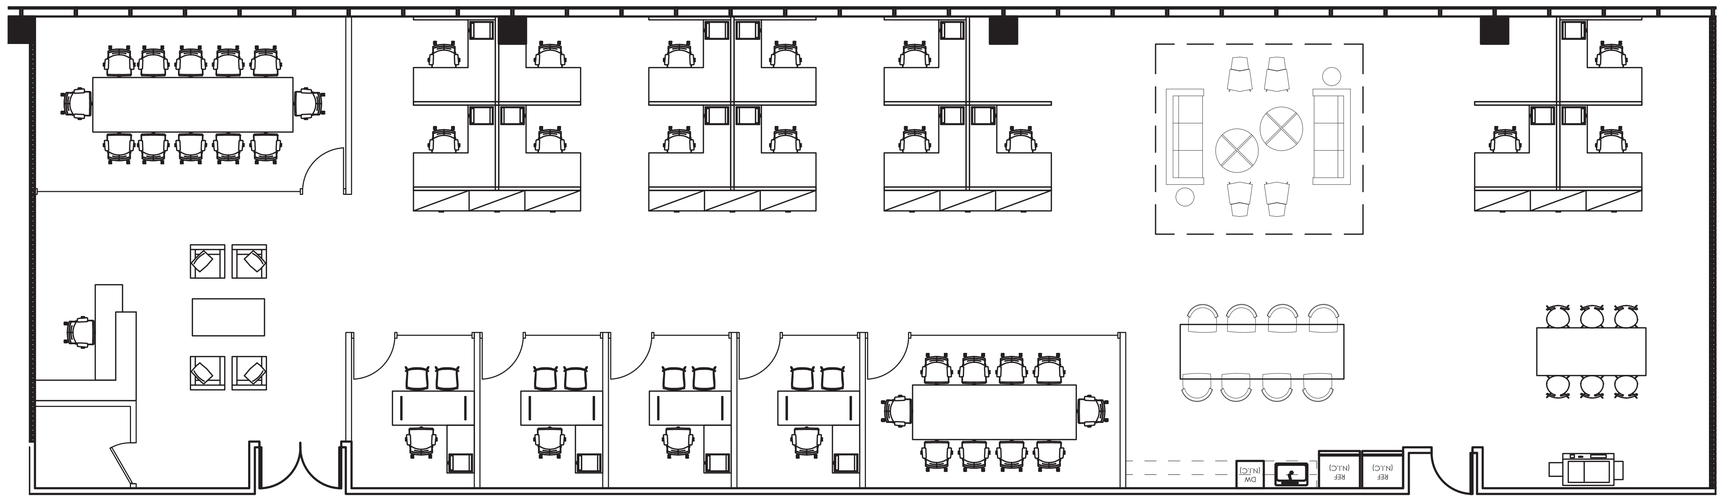

onni group