
SUITE: **240** RSF: **5,500**


MANHATTAN BEACH TOWERS

AS-BUILT CONFIGURATION

OFFICES	6
CONFERENCE ROOM	1
OPEN WORK AREA	+/- 29
BREAK OUT / LOUNGE	1
PANTRY	1

KEY PLAN

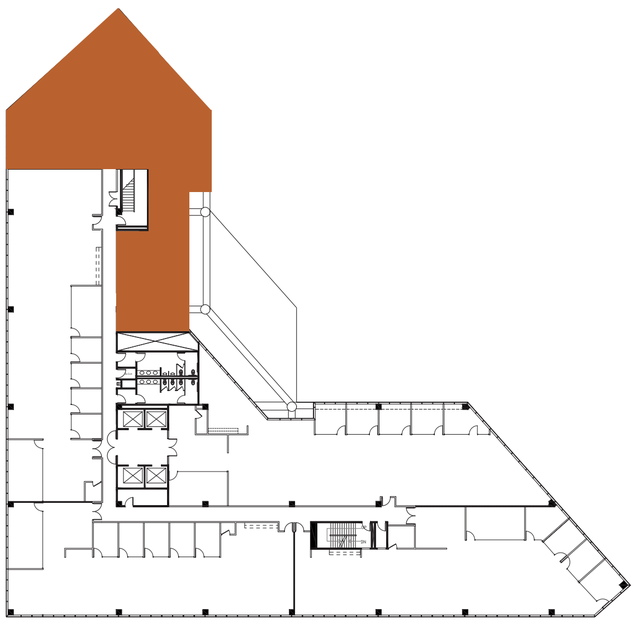

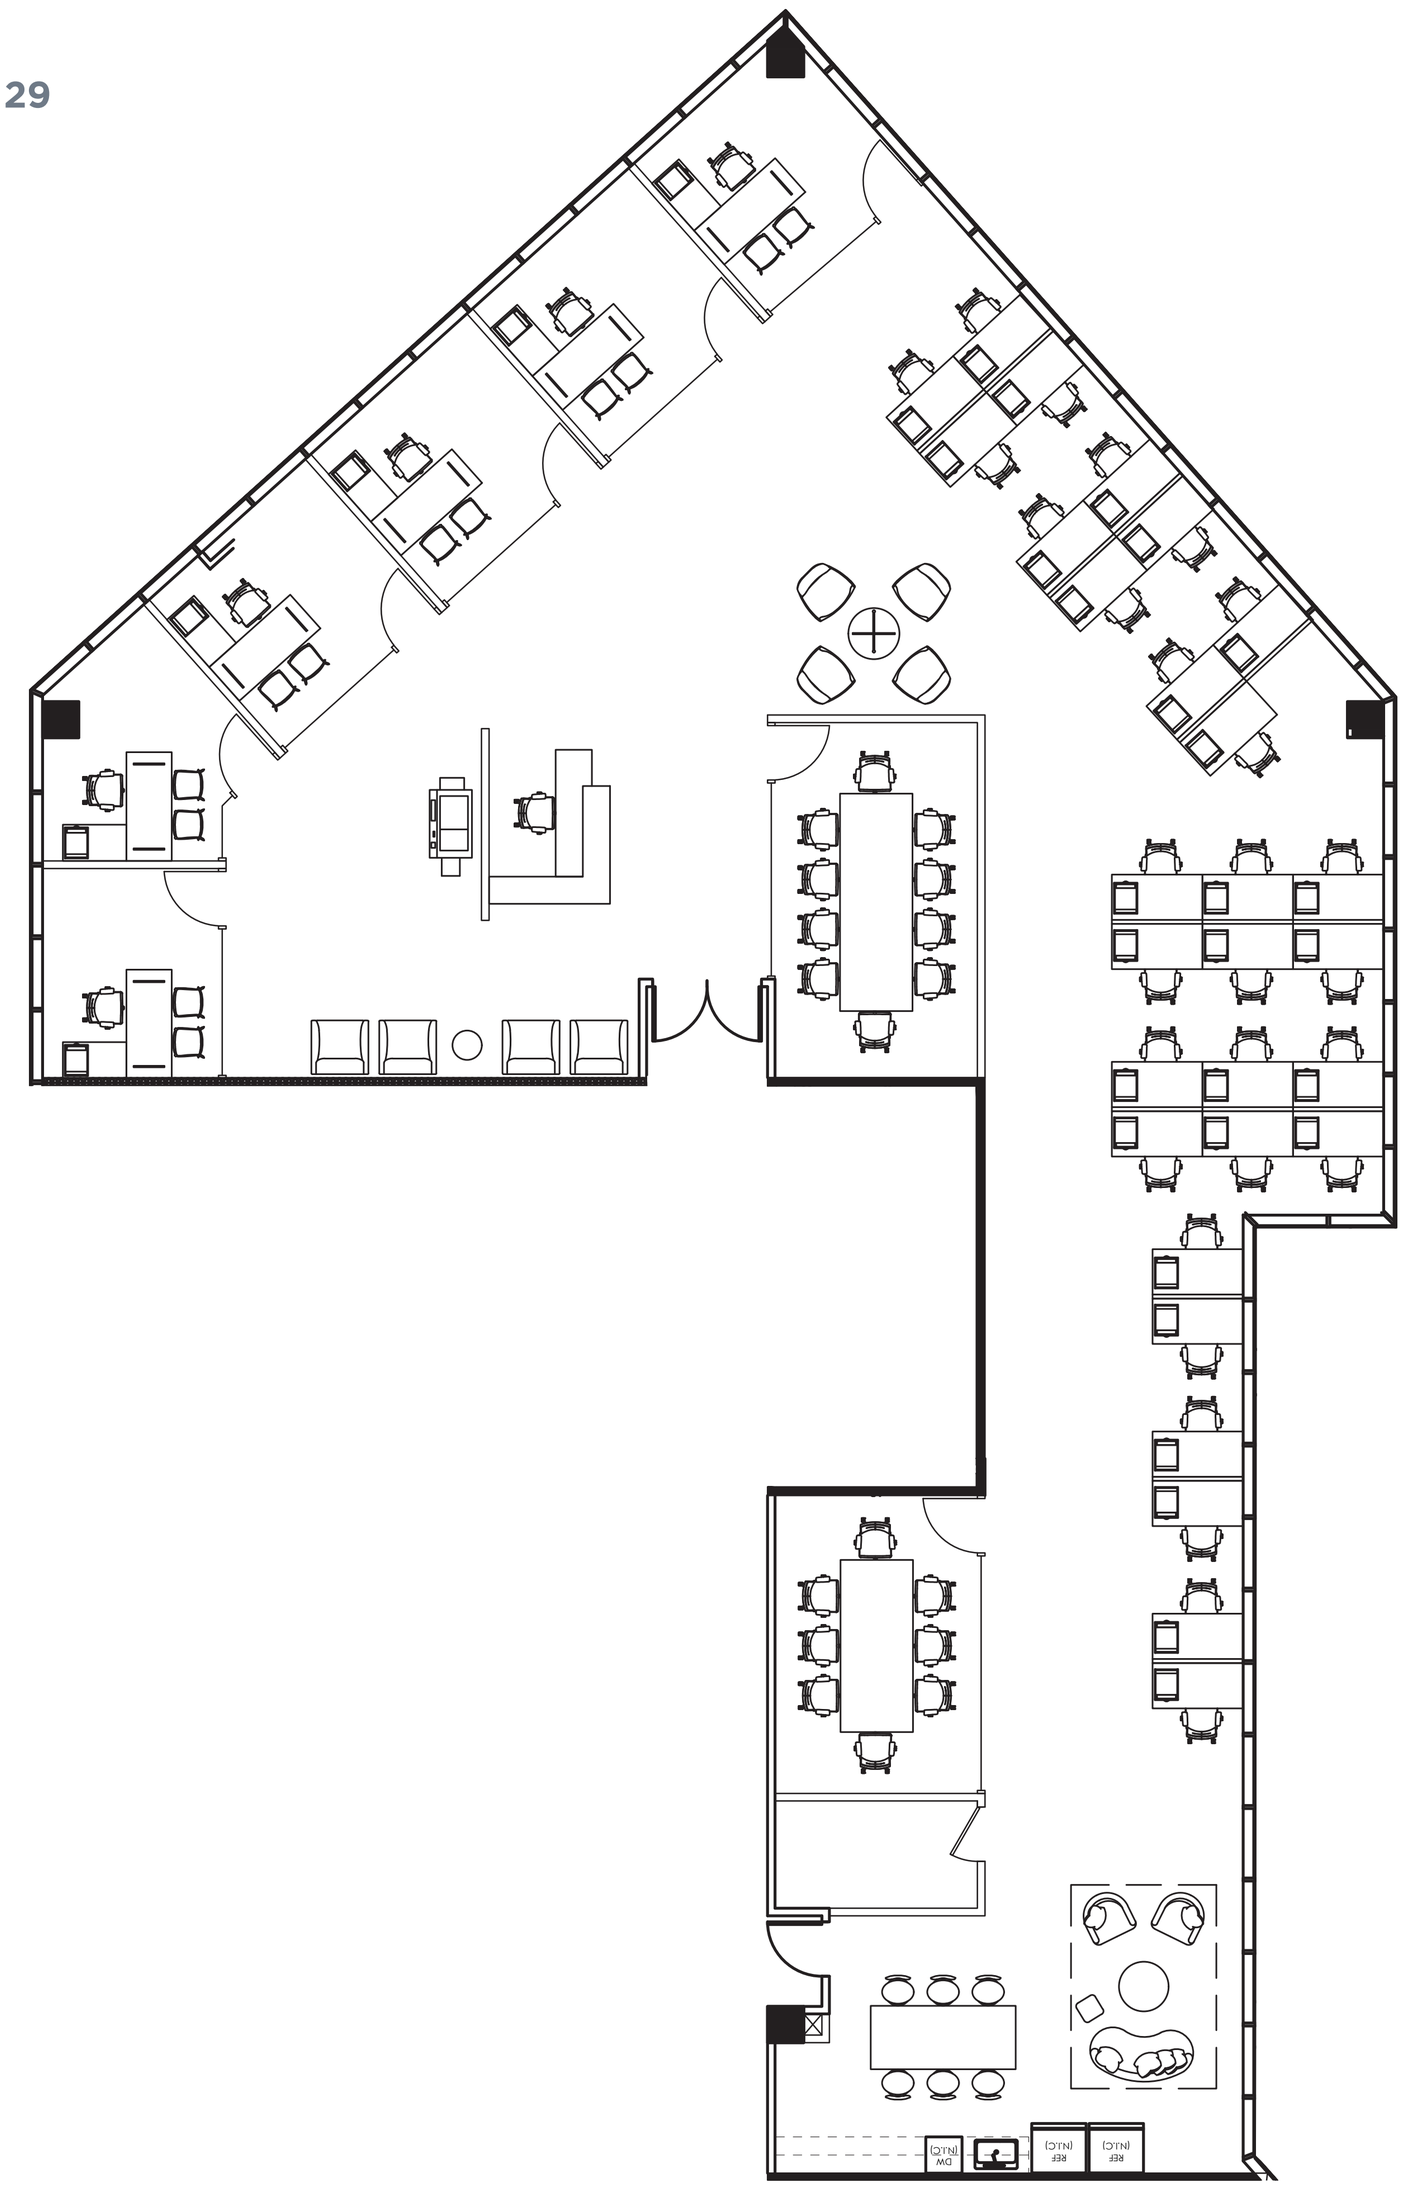

onni group